


T.3S. R.38E.W.M.

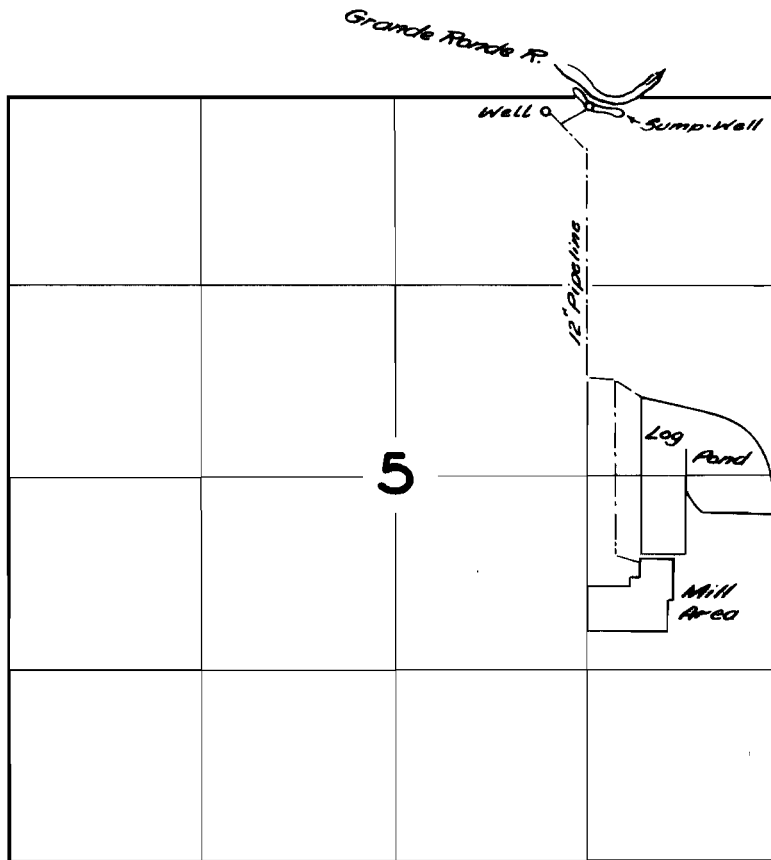

FINAL PROOF SURVEY UNDER

Application No. *G-987* Permit No. *G-920*
IN NAME OF

Mount Emily Lumber Co., A Division of Katsatz Lumber Co.

Surveyed *Aug. 4* 1959, by *C.O. Baule*