


T. 1 N. R. 14-15 E. W. M.

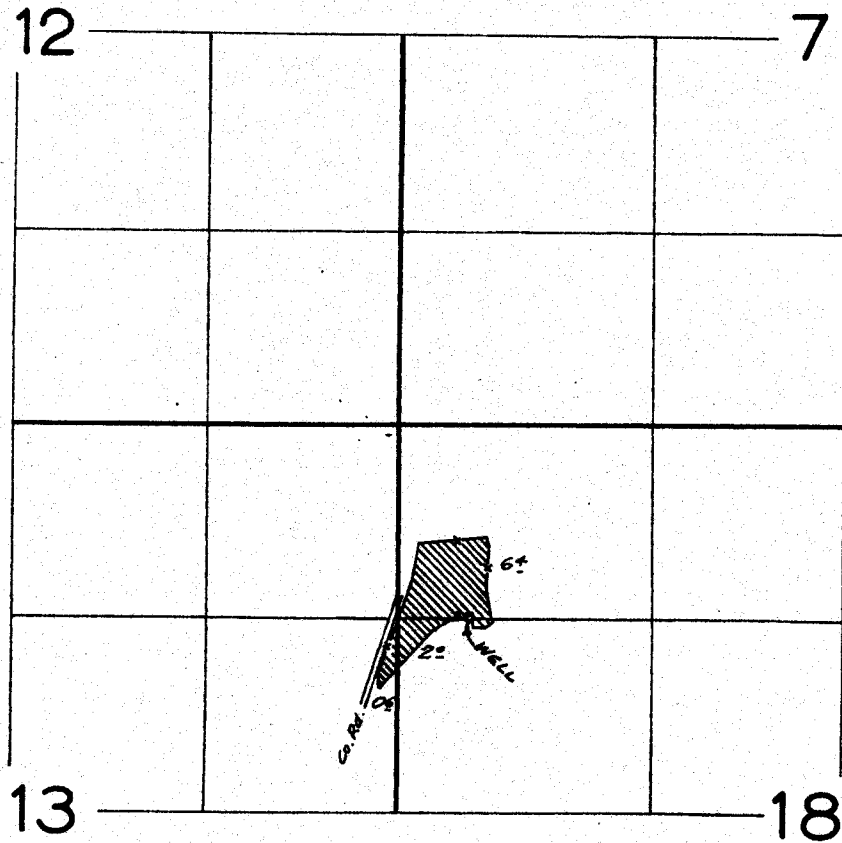

FINAL PROOF SURVEY

UNDER

Application No. G-1105. Permit No. G-981

IN NAME OF

LOUIS J. KELLY

Surveyed Nov. 14 1959, by R. Jackson