


T.40 S.R.11 & 12 E.W.M.

East River wells

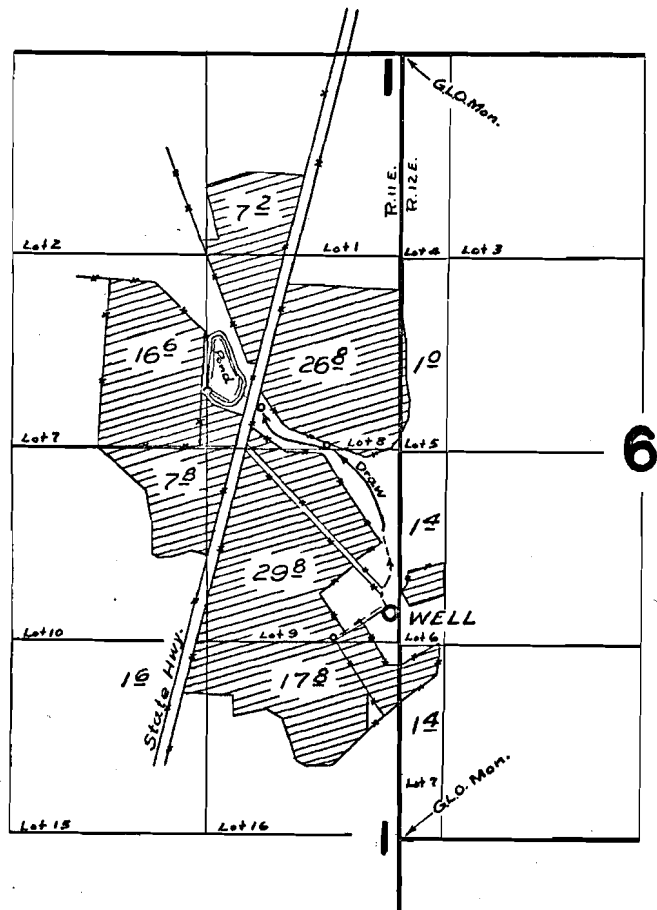

FINAL PROOF SURVEY

UNDER

Application No. G-1252 Permit No. G-1080

IN NAME OF

FRANCIS OSCAR & MARGARET WILLNETTA FREUER

Surveyed 19 Oct. 1959, by M. B. Bish