


G-1095
27003

T.6N.R.35E.W.M.

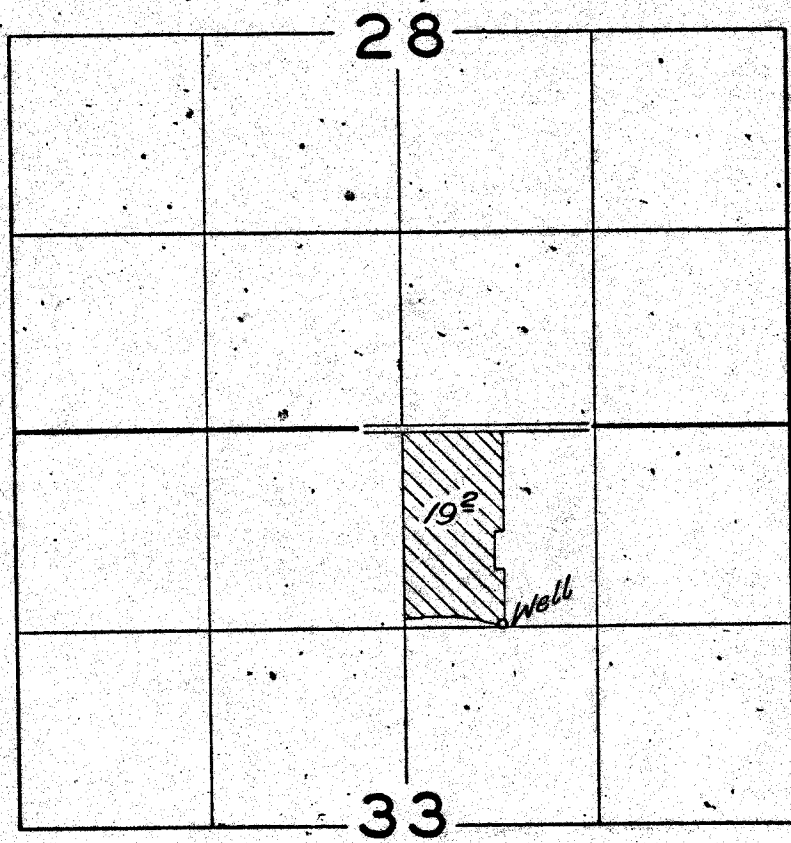

FINAL PROOF SURVEY

UNDER

Application No. G-1088 Permit No. G-1095

IN NAME OF

Richard H. Knopf

Surveyed Oct. 21, 1959, by A.O. Curtis
NE-57-60