


T.6N. R.35E.W.M.

Washington

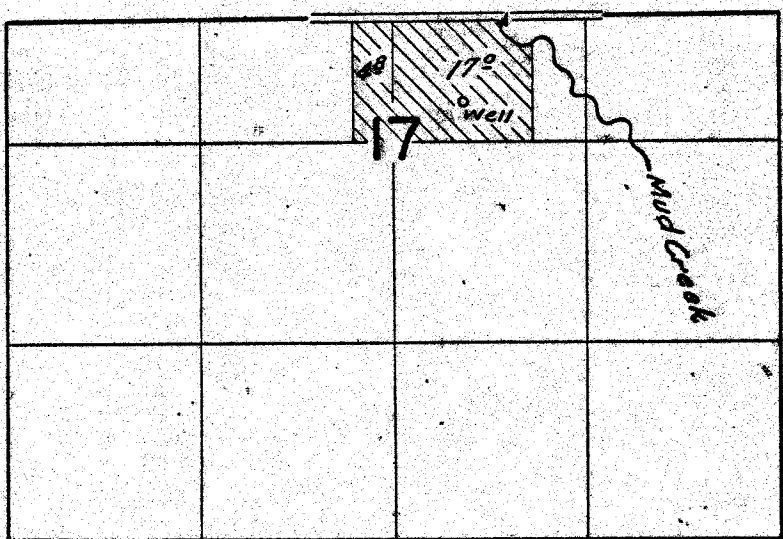

FINAL PROOF SURVEY

UNDER

Application No. G-1226 Permit No. G-1117

IN NAME OF

Alvin R. Zickuhr

Surveyed Oct 23 1959, by C. O. Bartels