


T.6N.R.35E.W.M.

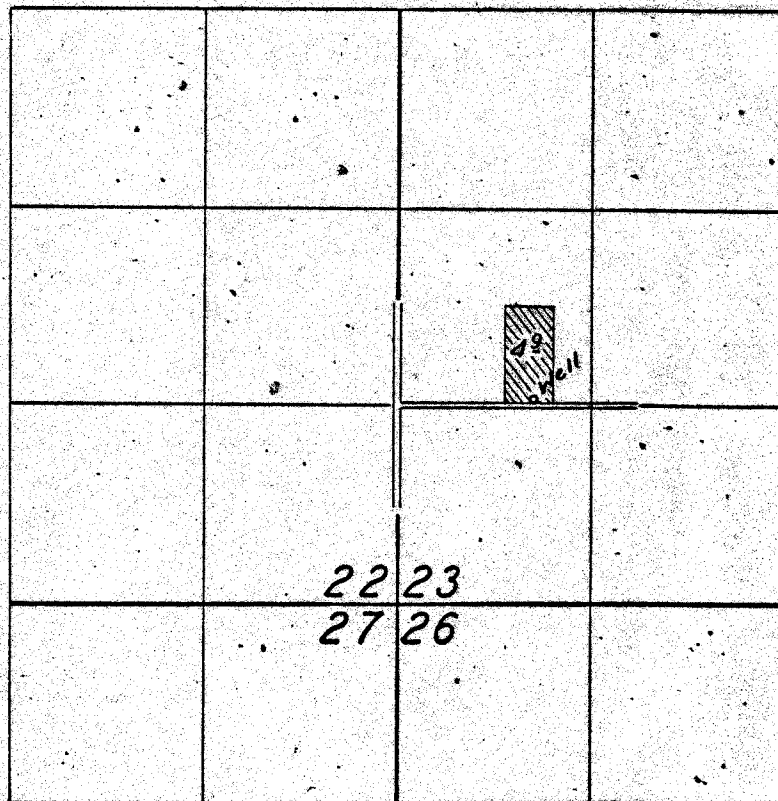

## FINAL PROOF SURVEY

UNDER

Application No. G-1307 Permit No. G-1168

IN NAME OF

Bessie DyerSurveyed Oct 28 1959, by C. C. Smith