


T.39SR.11 1/2 E.W.M.

Lost River Wells

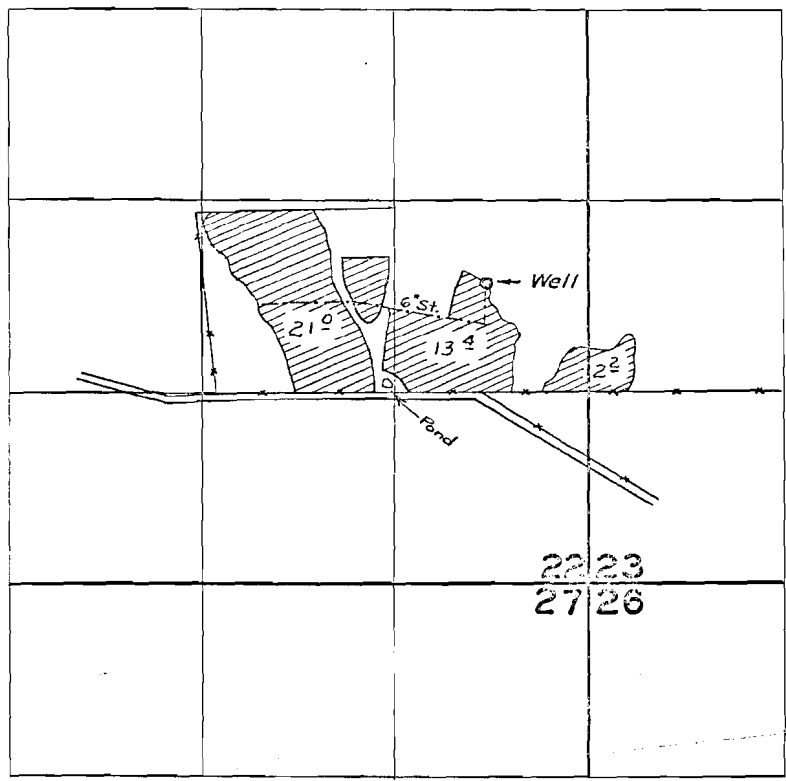

FINAL TROOP SURVEY BY

UNDER

Application No. U-394 ... Final No. U-362

IN FAVOR OF

PAUL T. HATCHETT

Surveyed 19 Oct. 1959, by *Tm. Bush*