


U-413

T.2N.R.13E.W.M.

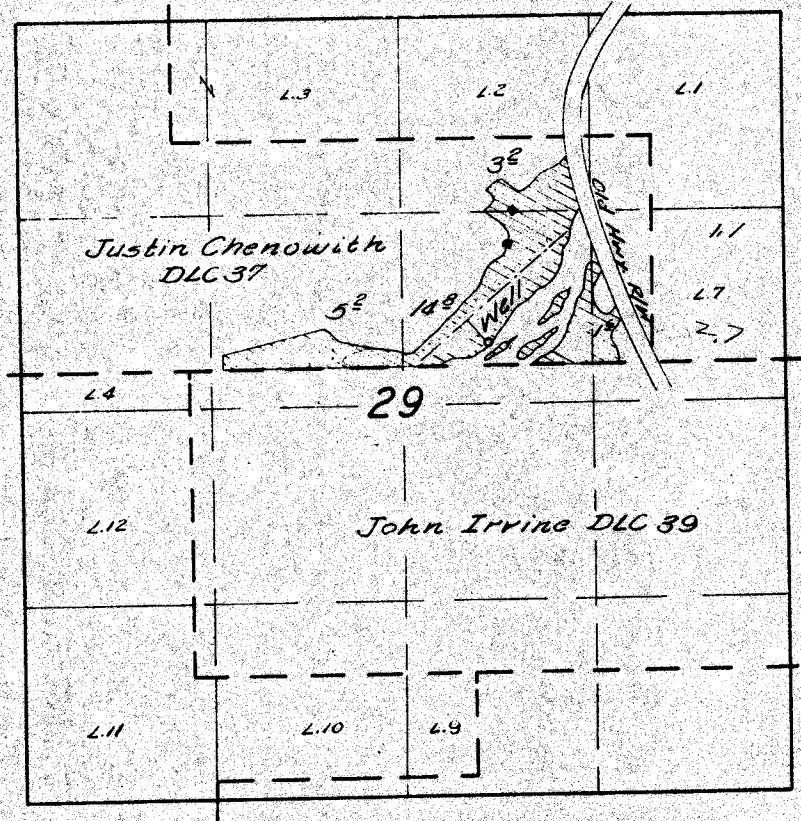


FINAL PROOF SURVEY

UNDER

Application No. U-442 Permit No. U-413

IN NAME OF

Fred Wetle

Surveyed Nov. 11, 1959, by C. O. Burt