


T. 2 S. R. 38 E. W.M.

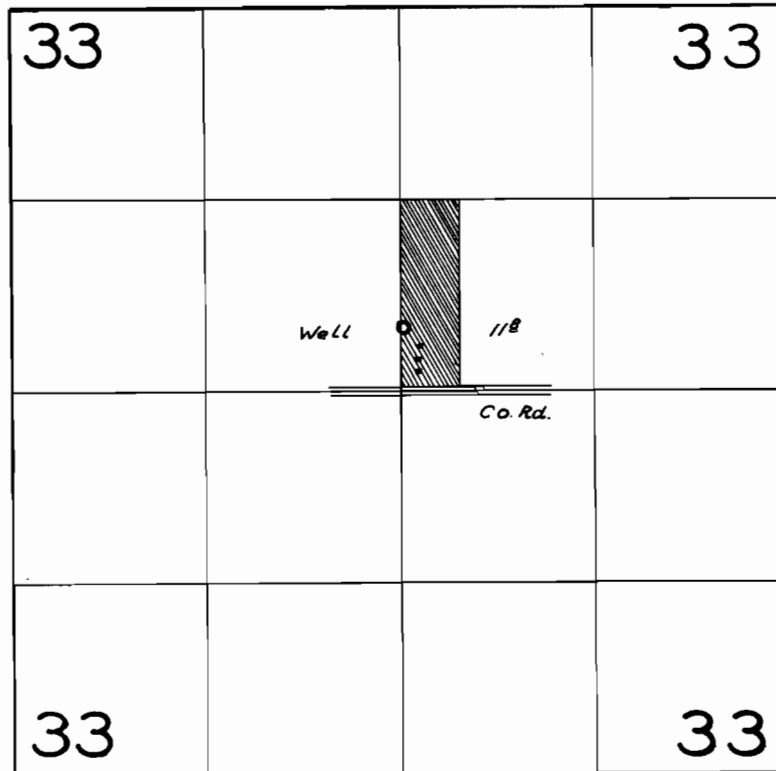

FINAL PROOF SURVEY
UNDER

Application No. *U-514* Permit No. *U-488*
IN NAME OF

Clyde C. Jones

Surveyed *Aug. 14, 1959*, by *R. H. Jackson*