


T.41 S.R.13&12 E.W.M.

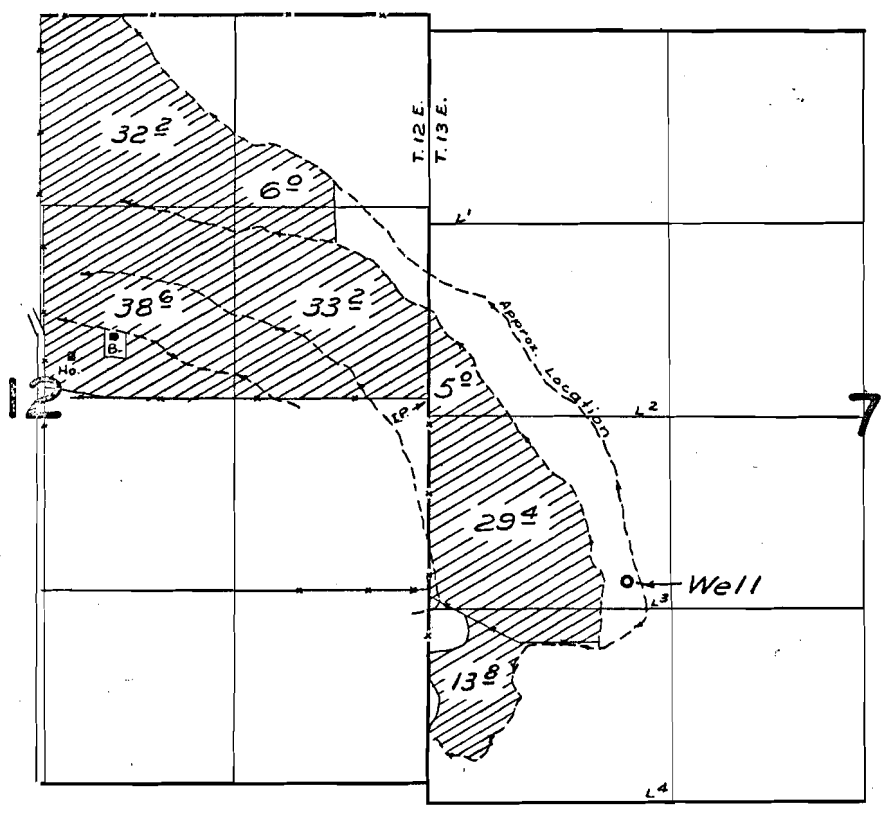

Just E. wells

FINAL PROOF SURVEY

UNDER

Application No. U-551 Permit No. U-503

IN NAME OF

HAROLD BARNEY

Surveyed 20 Oct. 1959, by T. B. Bish