


T.39 S.R.8 E.W.M.

Klamath Co. wells.

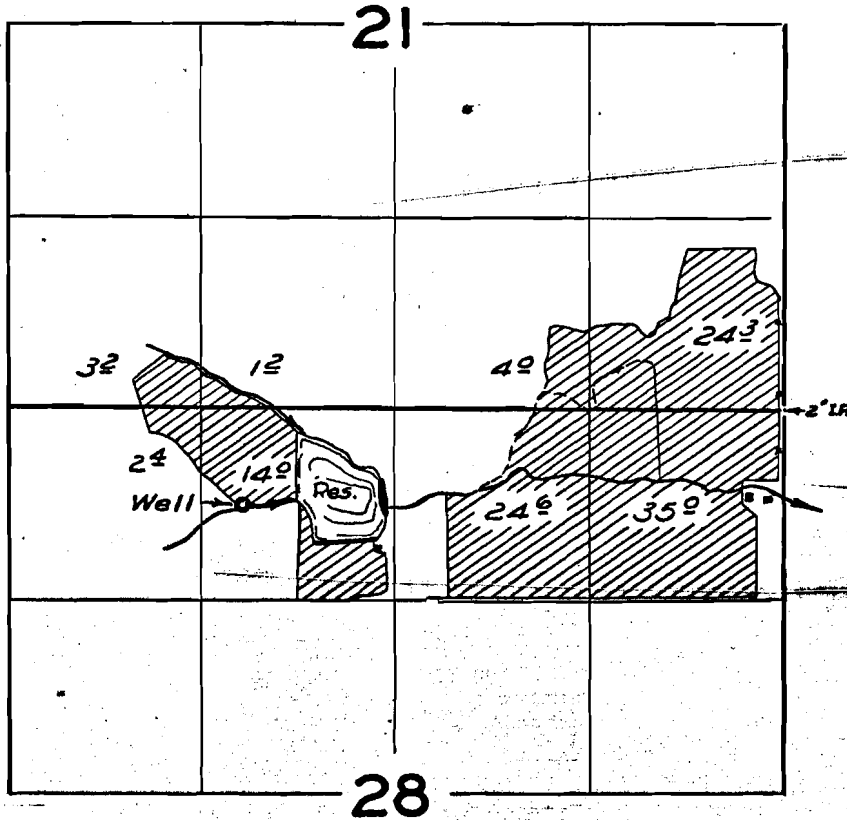

FINAL PROOF SURVEY

UNDER

Application No. U-560 Permit No. U-508

IN NAME OF

MRS. GEORGE W. AGER

Surveyed 27 Oct. 1950, by M. B. Bell