


T.38S. R.1 1/2 E.W.M.

Burke Crk; Yuma Valley wells

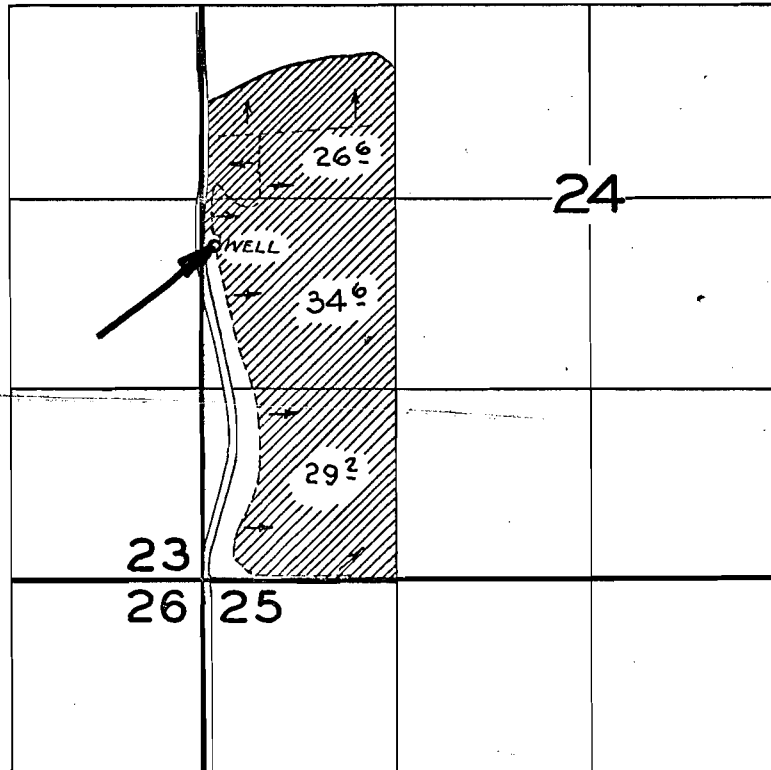

FINAL PROOF SURVEY
UNDER

Application No. U-463 Permit No. U-564
IN NAME OF

VIRGIL W. SCHMOE

Surveyed 29 April 1958, by C.O. Bartels...