


T.28 S.R.16 E.W.M.

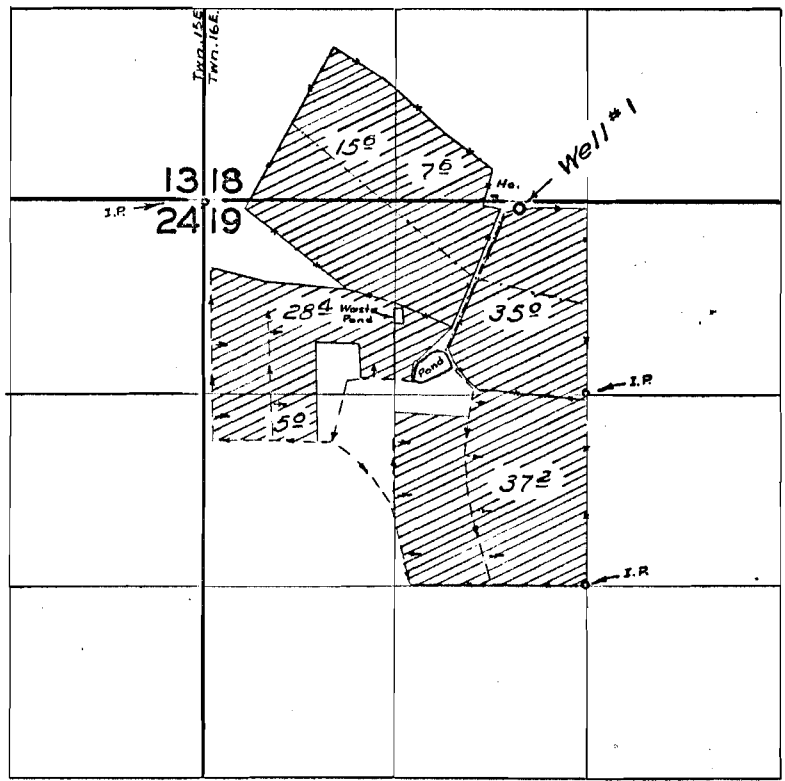

FINAL PROOF SURVEY UNDER

Application No. U-656 Permit No. U-597
IN NAME OF

ALBERT E. ALBERTSEN

Surveyed 5 May 1959, by M. B. Bieh