


T. 17-18 S. R. 40-41 E. W.M.

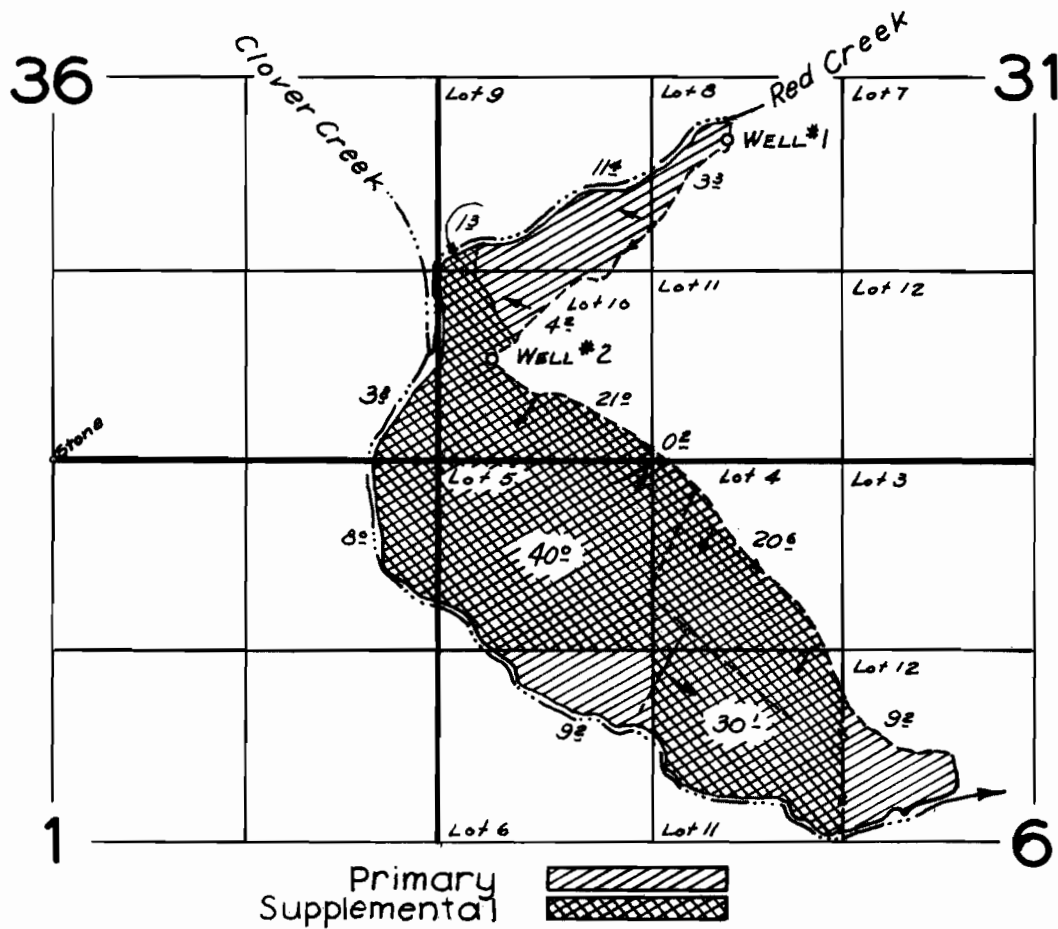

FINAL PROOF SURVEY

UNDER

Application No. U-565 Permit No. U-622

IN NAME OF

HERMANÉ DENA JORDAN

Surveyed Sept. 21 1959, by RH Jackson