


# T.38 S.R.1 1/2 E.W.M.

Buck Cr: Yanna Valley wells

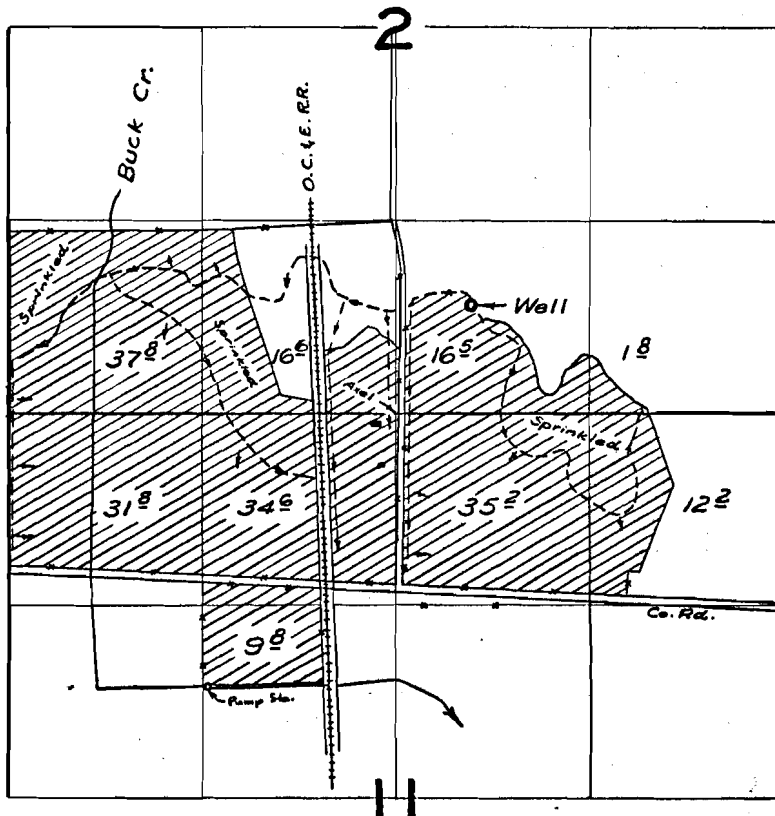

## FINAL PROOF SURVEY

UNDER

Application No. U-464 Permit No. U565

IN NAME OF

JESSE J. ANGEL, JR.

Surveyed 15 Oct. 19 59, by M. B. Bish