


# T.40 S.R.1 E.W.M.

East River Weeds

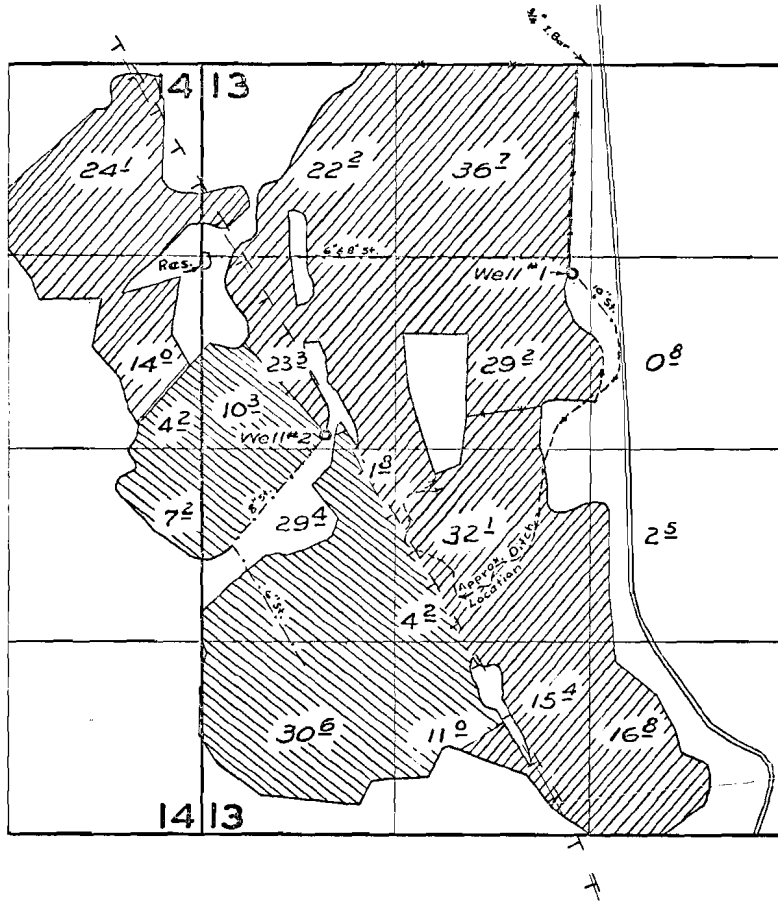

## FINAL PROOF SURVEY

UNDER

Application No. U-502. Permit No. U-457.

IN NAME OF

LADDIE & CARL RAJNUS

Surveyed 23 Oct 1959, by *m. Reel*