


T.26&27S.R33E.W.M.

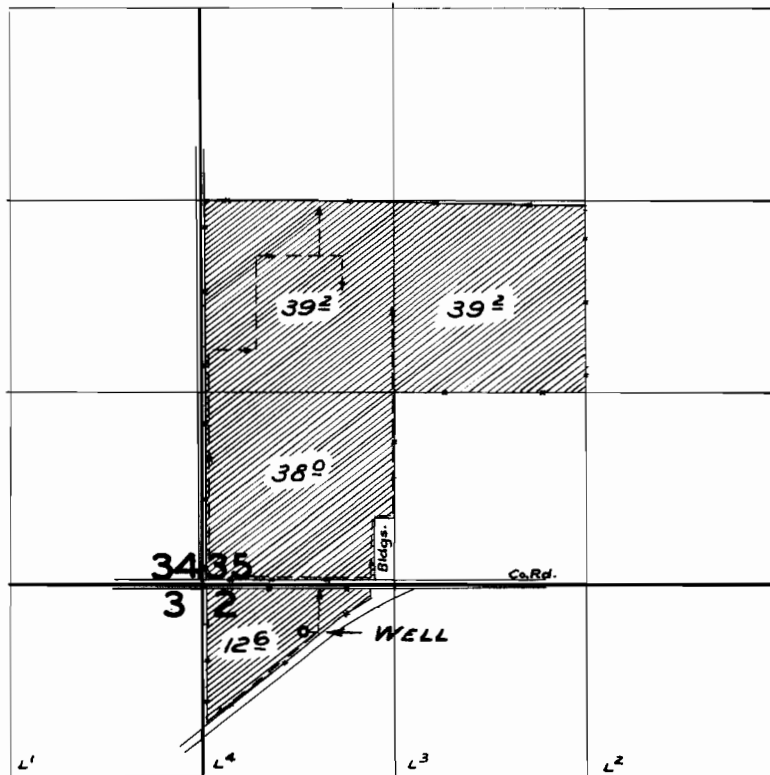

FINAL PROOF SURVEY UNDER

Application No. U-818 Permit No. U-724
IN NAME OF

E.A. Wing

Surveyed 5 Aug. 1958, by M. Bish