


T. 3 S. R. 39 E. W. M.

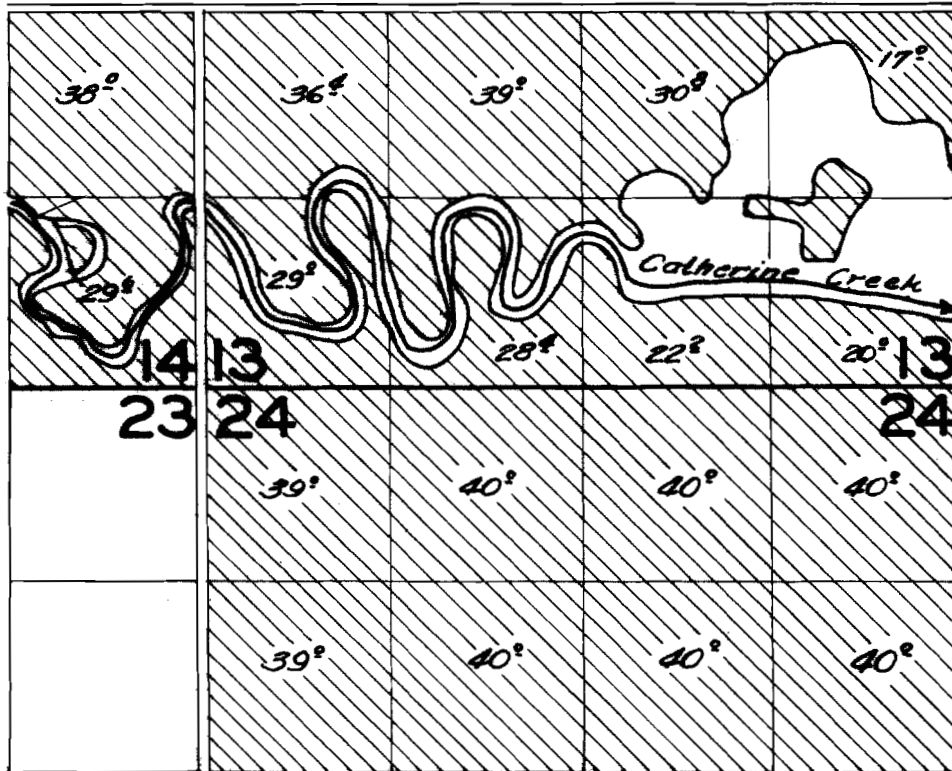

FINAL PROOF SURVEY

UNDER

Application No. 20582 Permit No. 16084

IN NAME OF

W. H. Woodruff

Surveyed Aug. 1919-59., by C. O. Smith