


T.13S. R.1W. & 1E.W.M.

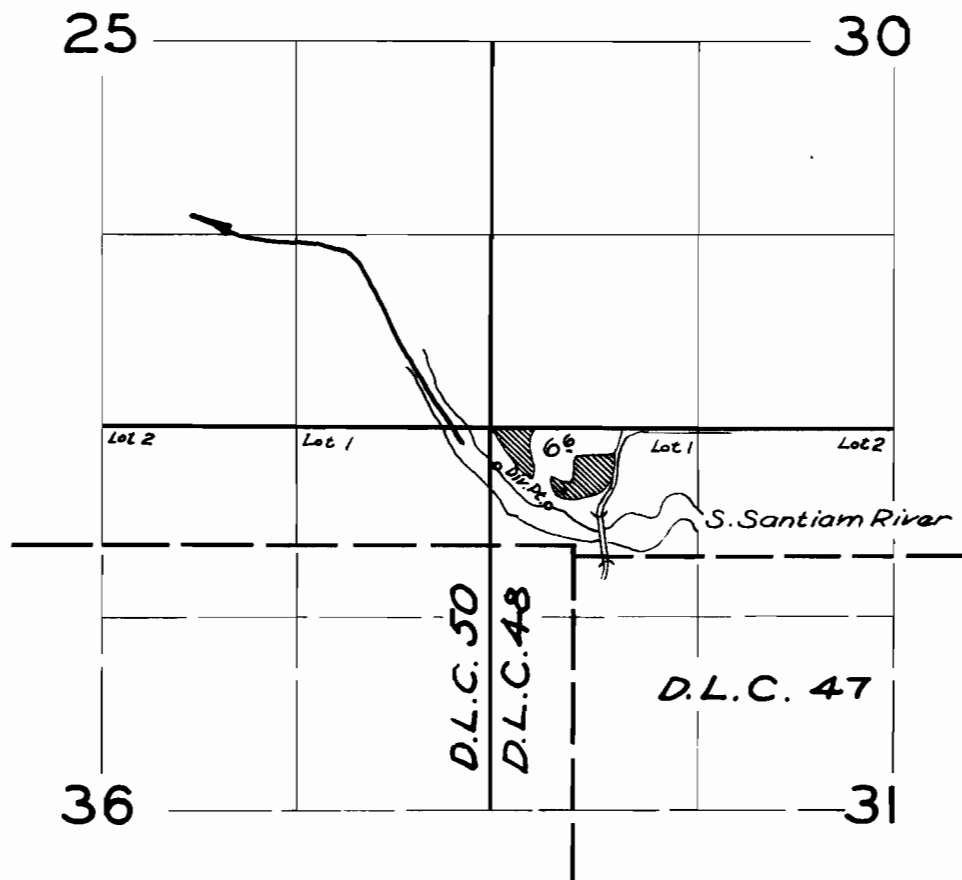

FINAL PROOF SURVEY
UNDER

Application No. 23283 Permit No. 18432
IN NAME OF

C. E. RIDLING

Surveyed 10 Sept. 1958, by C. O. Bartels