


18498

27023

T. 39S. R. 20E. W.M.

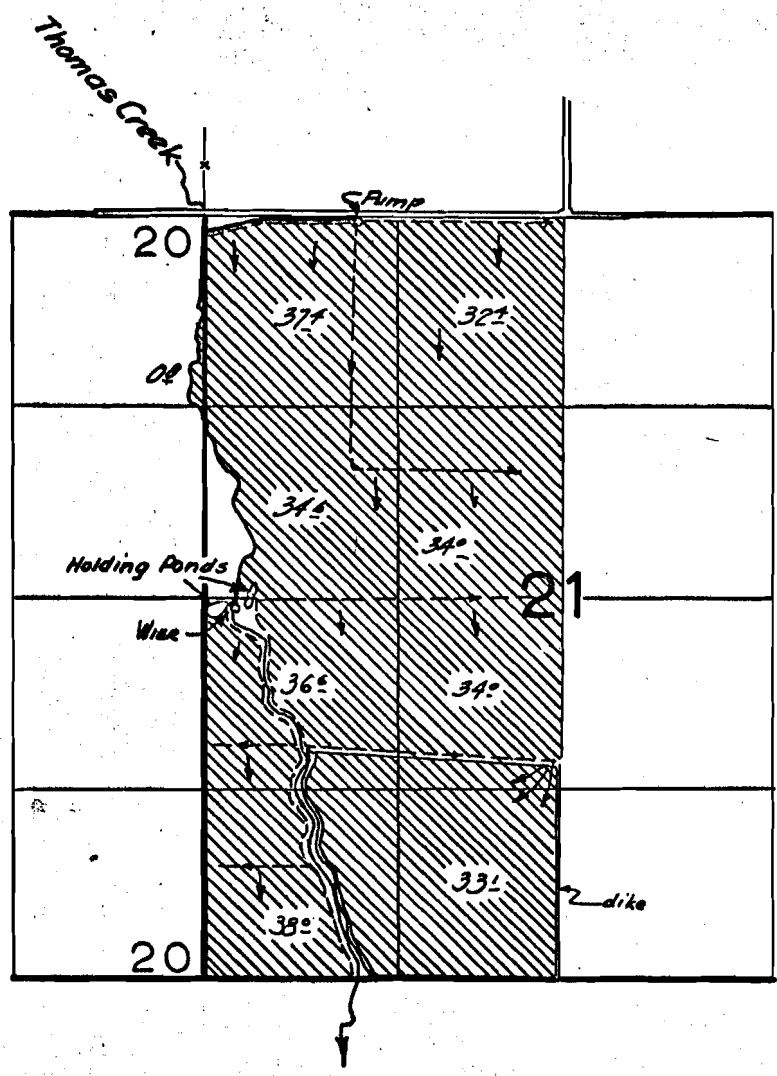

FINAL PROOF SURVEY UNDER

Application No. 23436. Permit No. 18498.
IN NAME OF

CLARENCE W. OGLE

Surveyed May 13, 1959, by R.H. Jackson

39-20 ✓
CH2-38K-151