


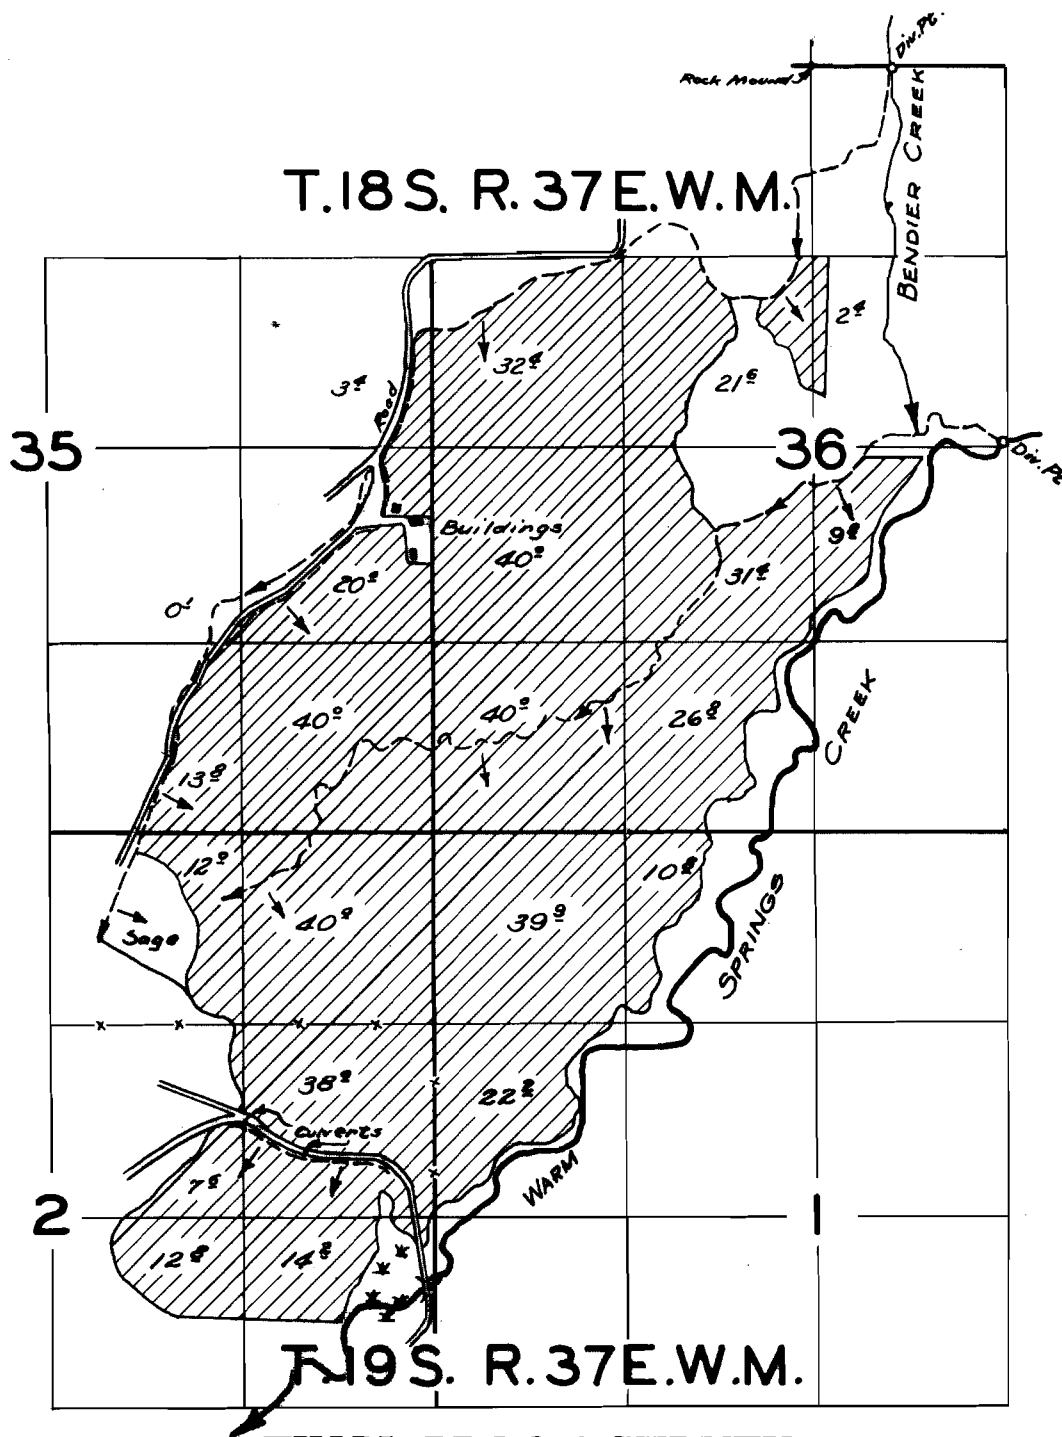

FINAL PROOF SURVEY
UNDER

R-13530
13531
R-23557 R-1005
Application No. 23558 Permit No. 19163
IN NAME OF

JAMES F. MURPHY

Surveyed 24 Oct. 1958, by C.O. Bartels