


T. 4 S. R. 39 E. W.M.

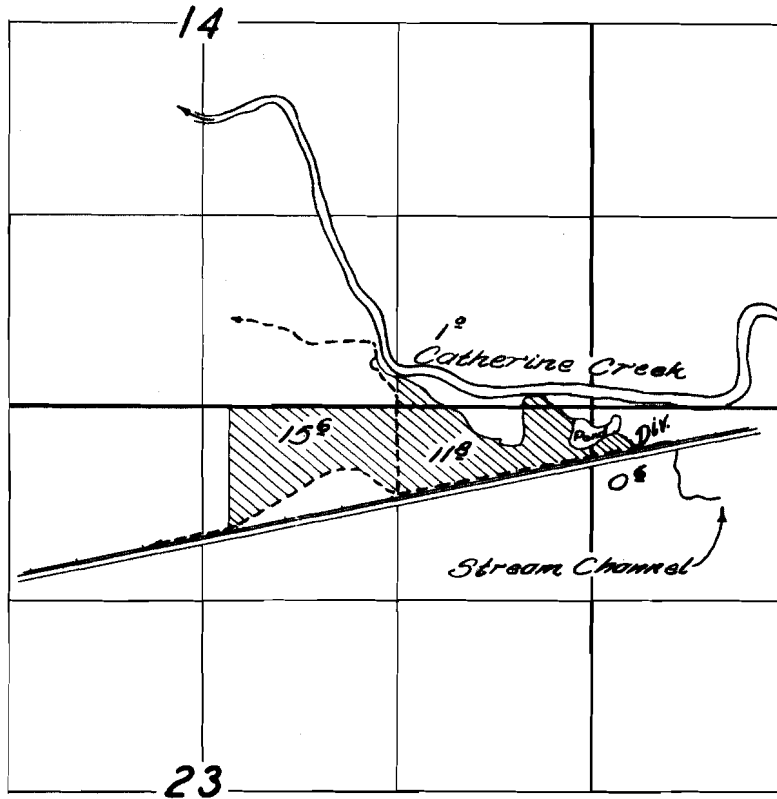

FINAL PROOF SURVEY

UNDER

Application No. 24121 Permit No. 19337

IN NAME OF

Forrest Scroggin

Surveyed Aug. 6, 1959, by C.D. Baugh