


T.10 S.R.I E.W.M.

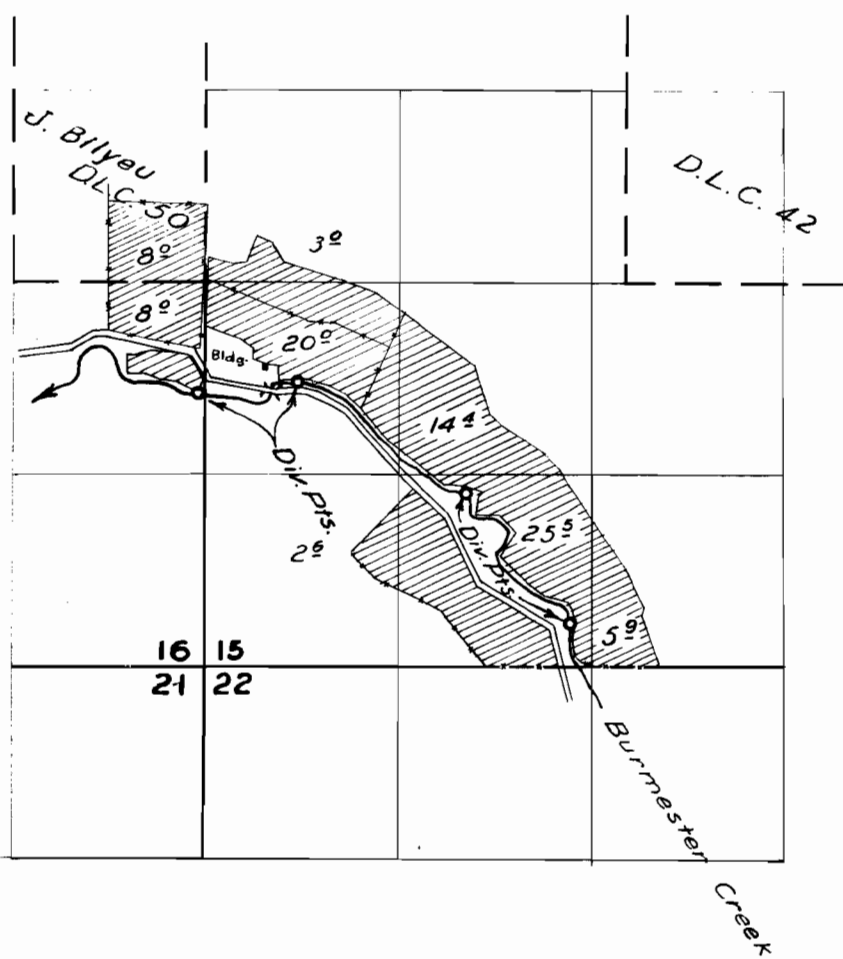

FINAL PROOF SURVEY UNDER

Application No. 24370. Permit No. 19452...
IN NAME OF

.....HAZEL WIRTH.....

Surveyed 2 July 1959, by M. Bish.....