


# T. 1 S. R. 38 E. W. M.

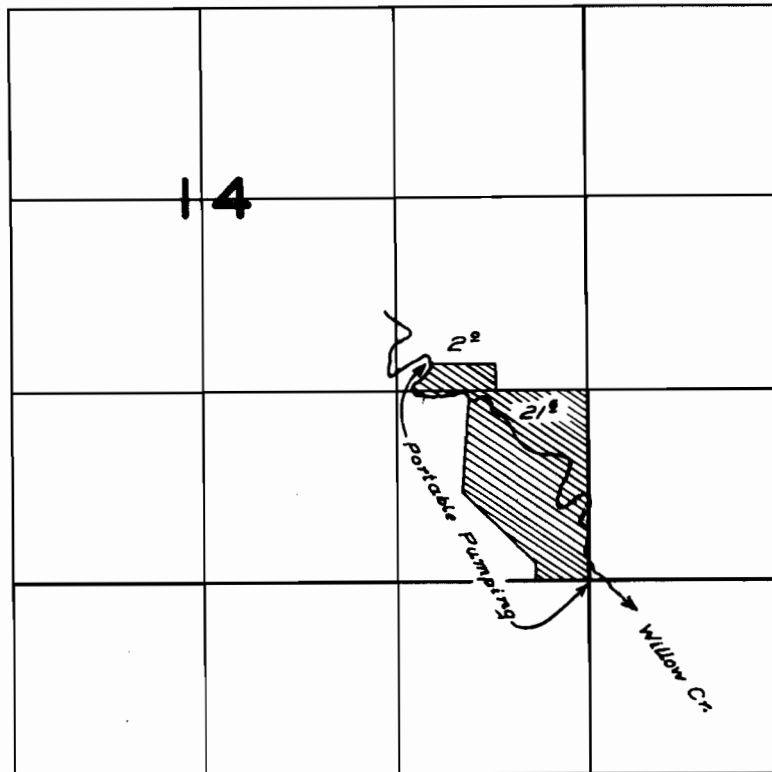

## FINAL PROOF SURVEY UNDER

Application No. 24756 Permit No. 19517  
IN NAME OF

Glyde H. McKenzie

Surveyed Aug. 4, 1959, by R.H. Jackson