


T.3S. R.38E.W.M.

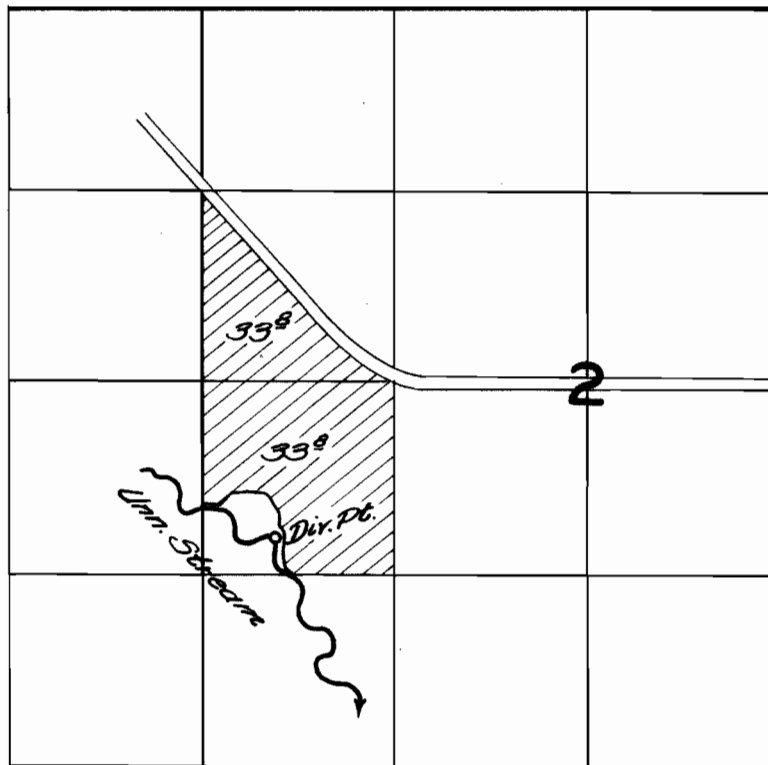

FINAL PROOF SURVEY

UNDER

Application No. 24800 Permit No. 19537

IN NAME OF

J. J. Schroeder

Surveyed Aug 14 1959, by C. O. Baubles

DVD-4M-24

8-23-73

Acres figure on map is
wrong for area hatched.
Proof was signed for 67.6 a
Only inspection since made
in connection w/ Per 34119 indicates
some new oil work including north
of road. Probably nothing can
be done now unless done
voluntarily by owner.

X