


T.2-3S. R. 38E.W.M.

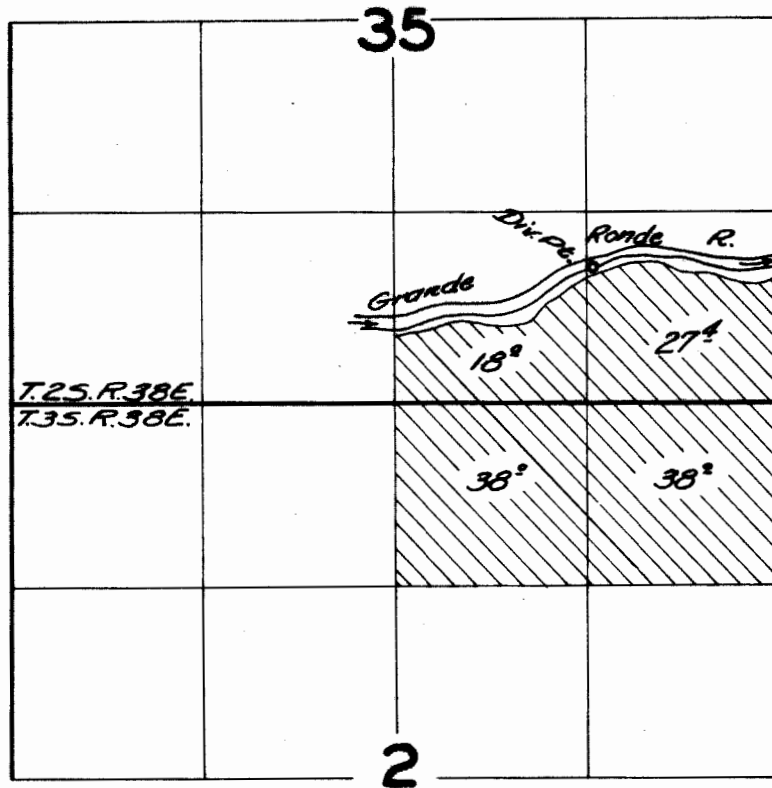

FINAL PROOF SURVEY

UNDER

Application No. 24811 Permit No. 19539

IN NAME OF

J. J. Schroeder

Surveyed Aug. 14, 1959 by C. O. Bartels