


T. 1 S. R. 38 E. W.M.

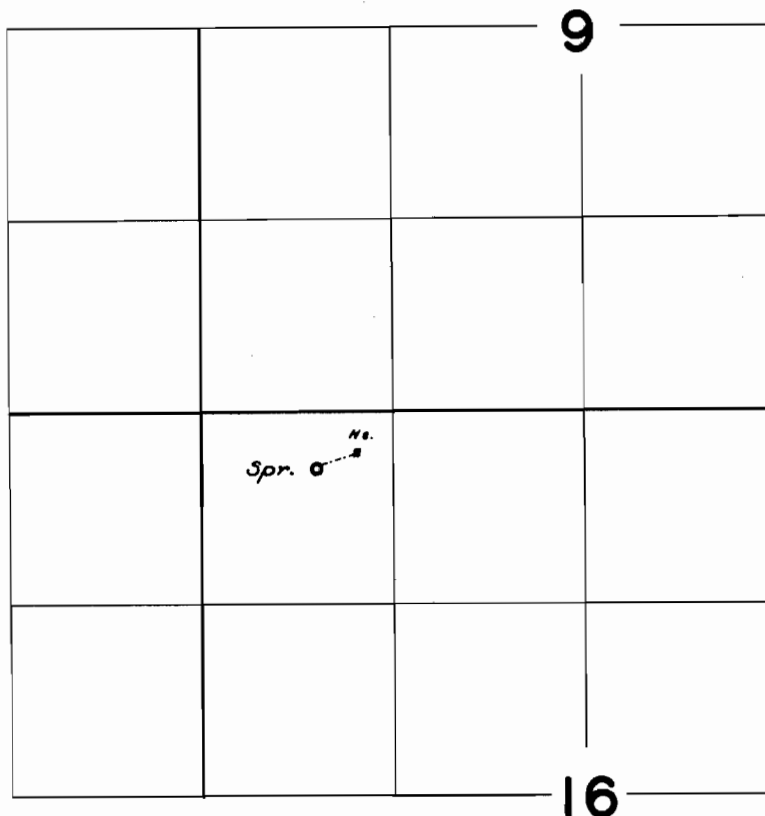

FINAL PROOF SURVEY
UNDER

Application No. 24982 Permit No. 19702
IN NAME OF

Edward O. & Eugene T. Moon

Surveyed Aug. 17, 1959, by R. H. Jackson