


T.2&3S.R.39E.W.M.

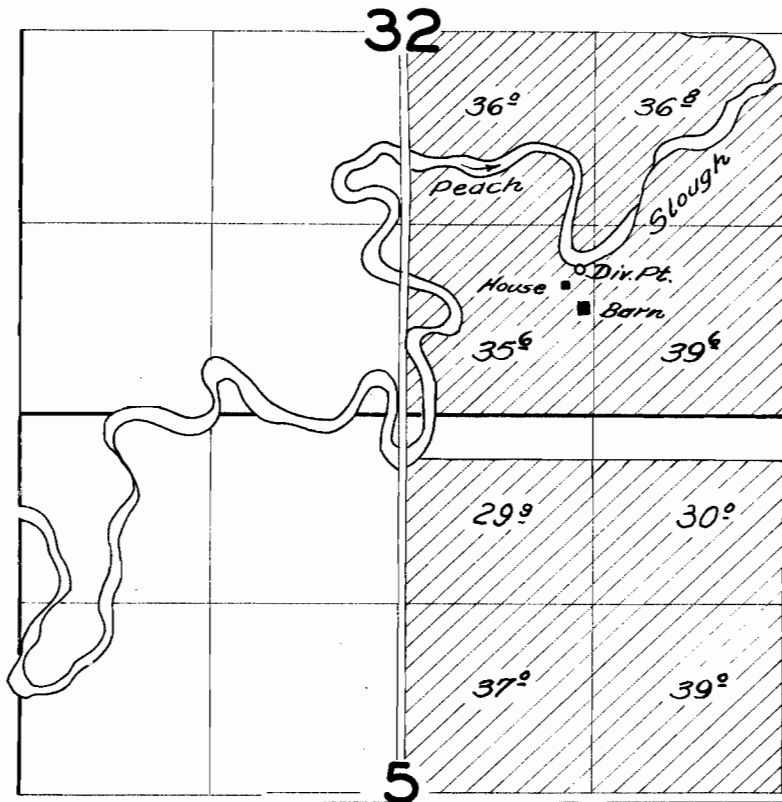

FINAL PROOF SURVEY

UNDER

Application No. 25587 Permit No. 20082

IN NAME OF

Claude Wright

Surveyed Aug. 4 1959, by C.O. Bartels