


T. 39 S. R. 20 E. W. M.

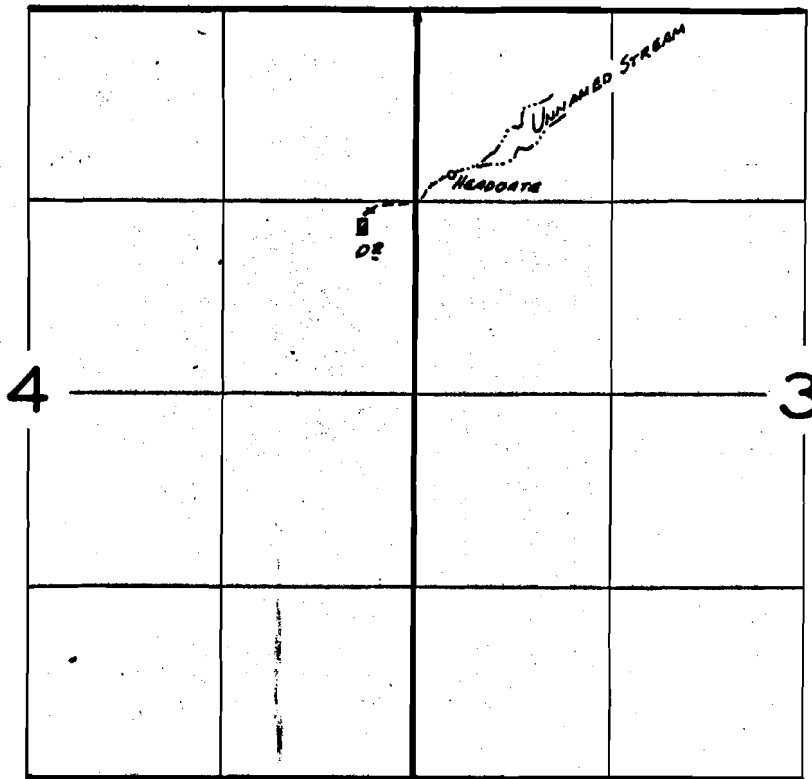

FINAL PROOF SURVEY
UNDER

Application No. 26263. Permit No. 20614...
IN NAME OF

R. E. & MARIE A. HARLAN

Surveyed May 14, 1959, by R. Jackson

39-20