


T. 1 S. R. 3 W. W. M.

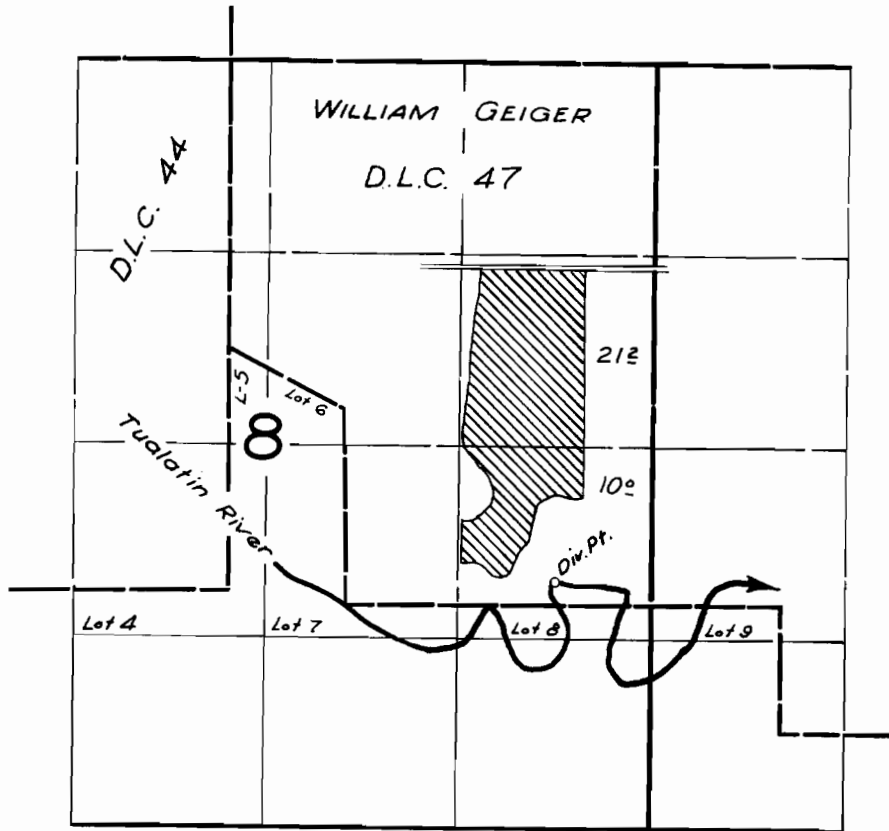

**FINAL PROOF SURVEY**  
UNDER

Application No. 26644 Permit No. 20871  
IN NAME OF

*M. A. LA FOLLETT*

Surveyed 27 May 1959, by *RH Jackson*