


T. 2S. R. 1W. W.M.

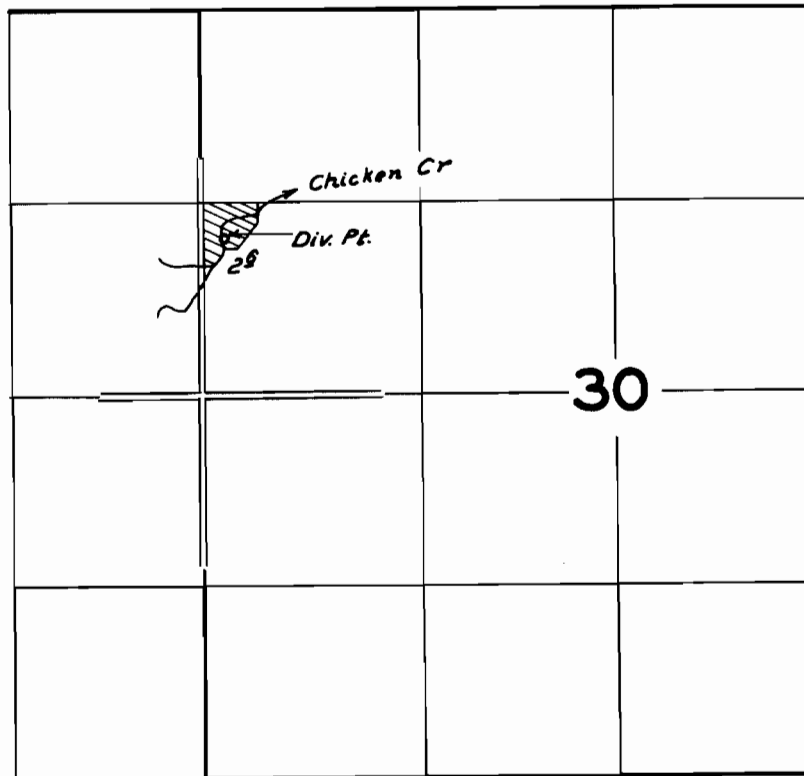

FINAL PROOF SURVEY
UNDER

Application No. *26821* Permit No. *21063*
IN NAME OF

Paul & Barbara Umland

Surveyed *Sept. 15, 1959*, by *C.O. Bartels*