


T. 13S. R. 1W W.M.

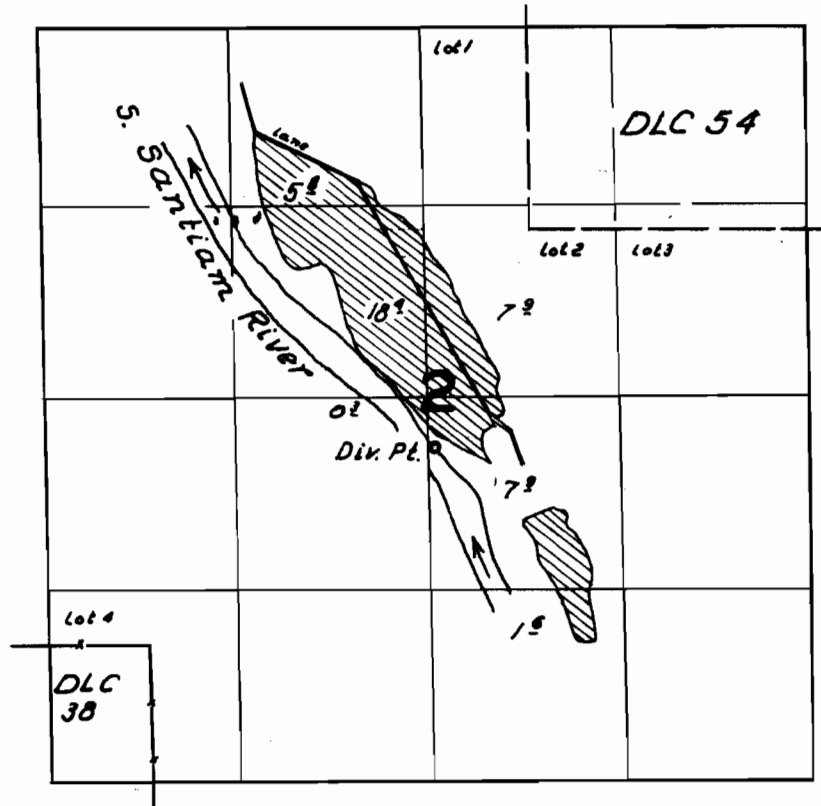

FINAL PROOF SURVEY

UNDER

Application No. 26897 Permit No. 21135

IN NAME OF

Leland E. & Kathryn Sprague

Surveyed Aug. 27 1959. by B.H. Jackson