T. 7S. R. 1E. W.M.

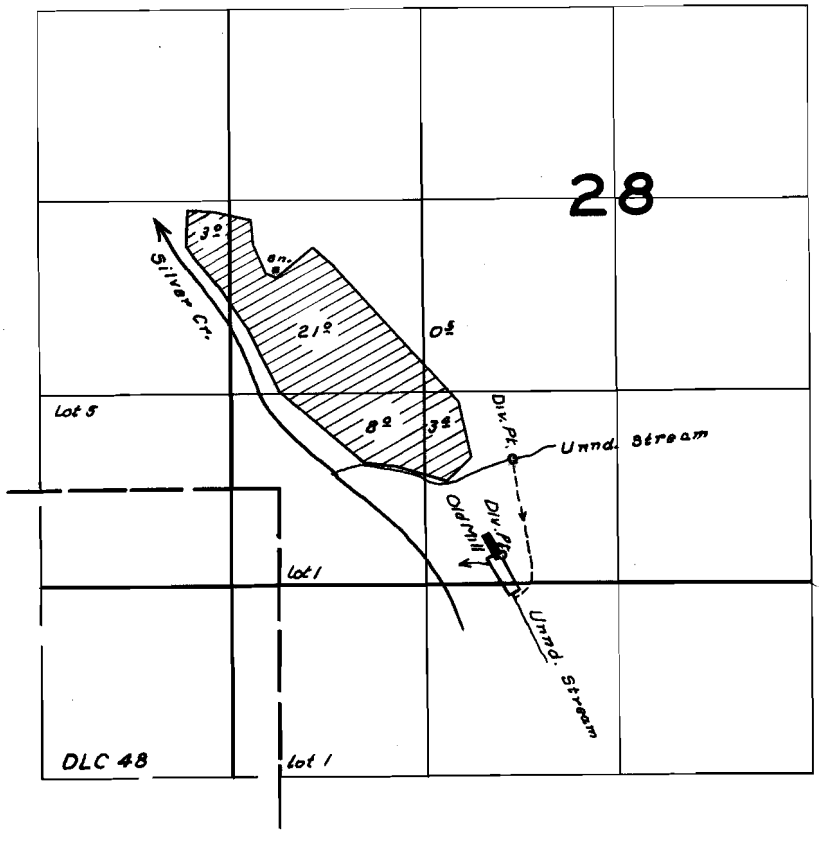

FINAL PROOF SURVEY
UNDER

R-27304 R-1372
Application No. 27305 Permit No. 21473
IN NAME OF

Willard Benson

Surveyed March 20 19 59, by R. H. Jackson

1959-N