


T. 7S. R. 1E. W.M.

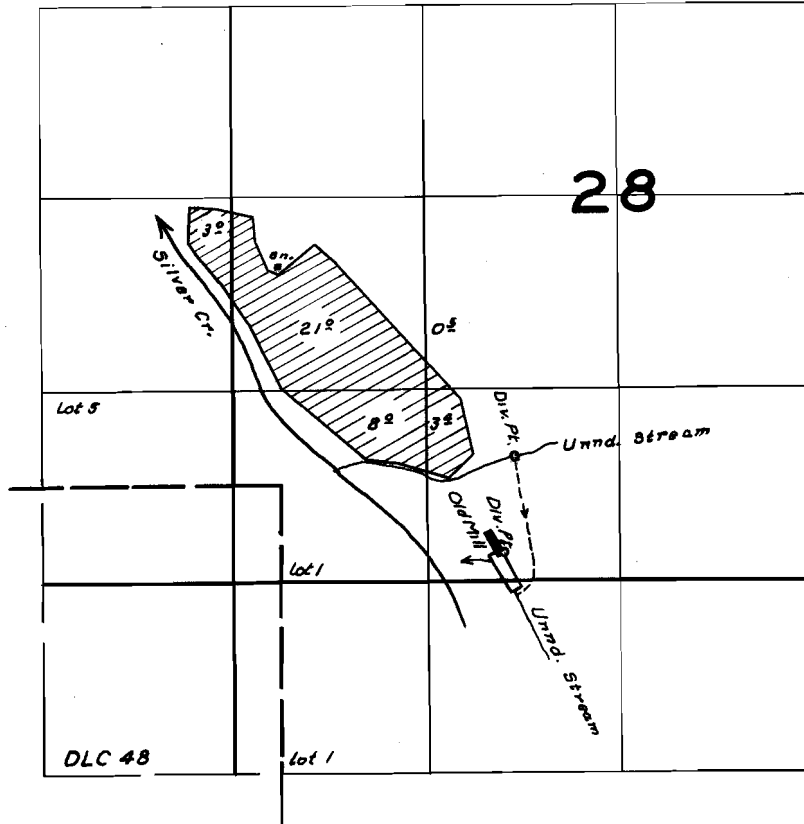

**FINAL PROOF SURVEY**  
UNDER

R-27304

R-1372

Application No. 27305 Permit No. 21473  
IN NAME OF

Willard Benson

Surveyed March 2019.59, by R.H. Jackson