


T. 7S. R. 1E. W.M.

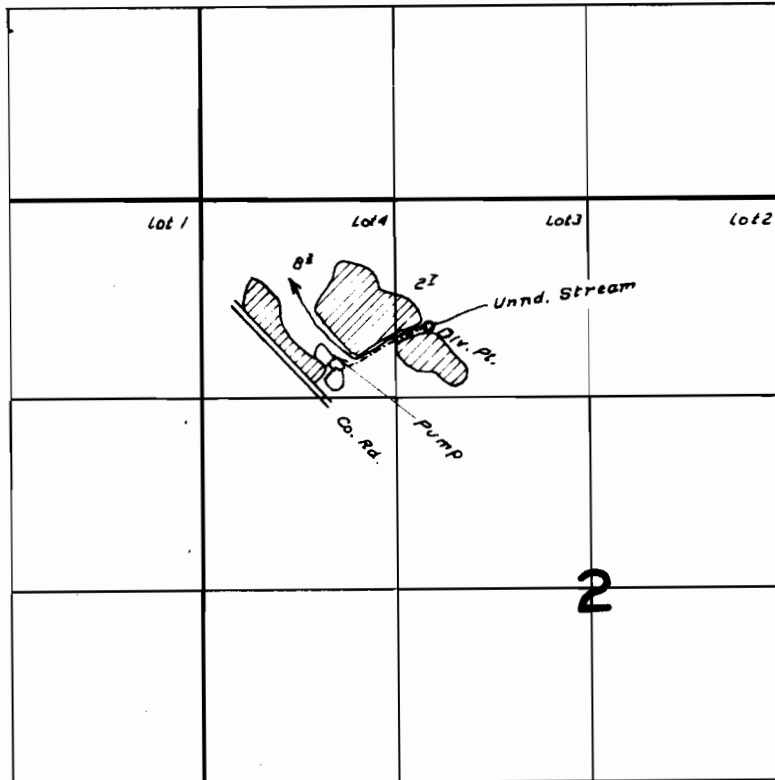

FINAL PROOF SURVEY UNDER

R-28317 *R-1493*
Application No. *28318* Permit No. *22265*
IN NAME OF

William J. or Eva E. Wilson

Surveyed *March 13 1959*, by *R.H. Jackson*