


T.7S. R.1E.W.M.

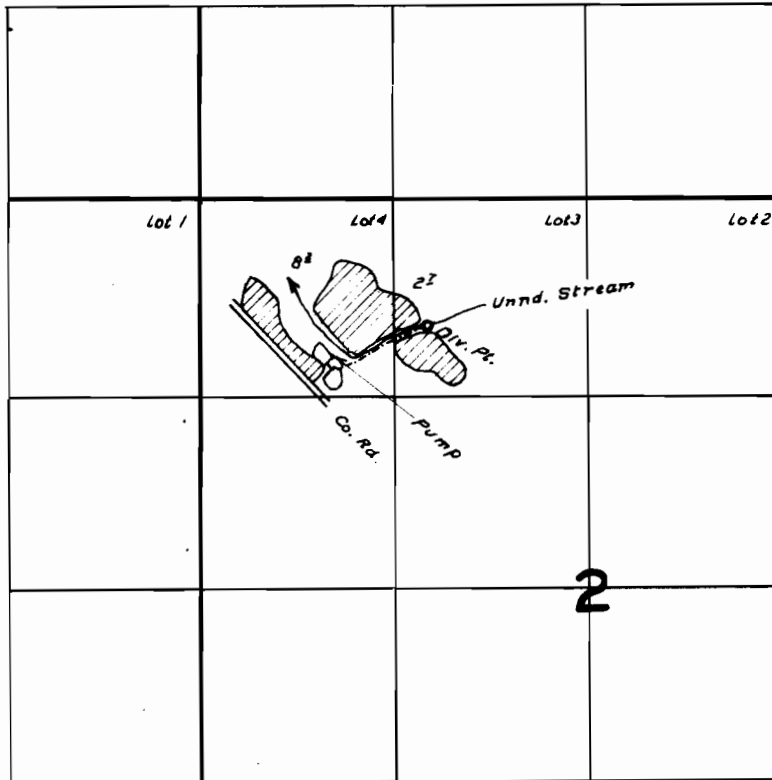

FINAL PROOF SURVEY UNDER

R-28317 *R-1493*
Application No. 28318 Permit No. 22265
IN NAME OF

William J. or Eva E. Wilson

Surveyed *March 13 1959*, by *R.H. Jackson*