


T. 36S. R. 3W. W.M.

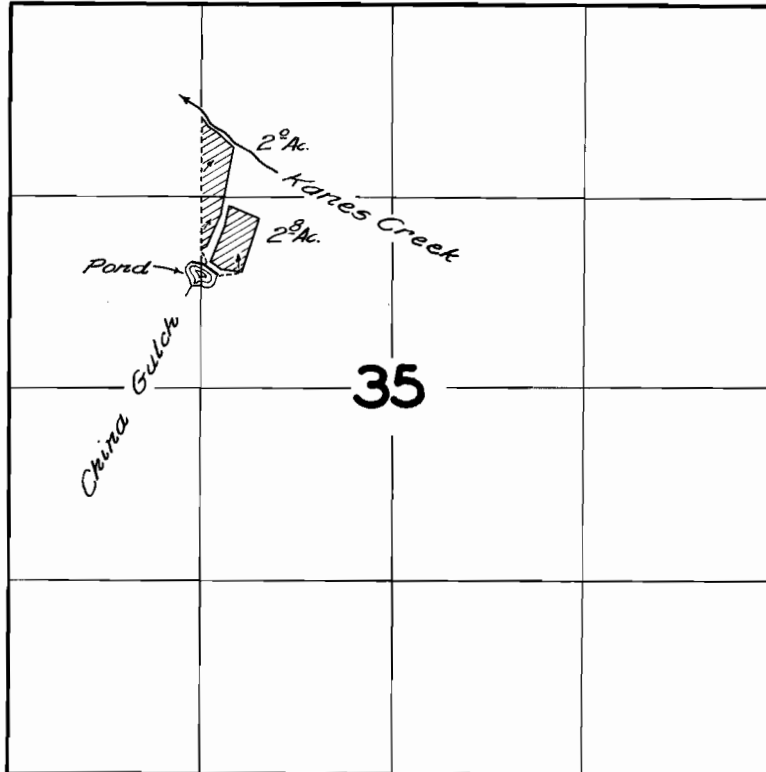

FINAL PROOF SURVEY
UNDER

Application No. *R-28323* *28324* Permit No. *R-1504* *22358*
IN NAME OF

.....*James N. Cornutt*.....

Surveyed *May 15* 1959, by *C.O. Bault*