


T.4 S.R.2 E.W.M.

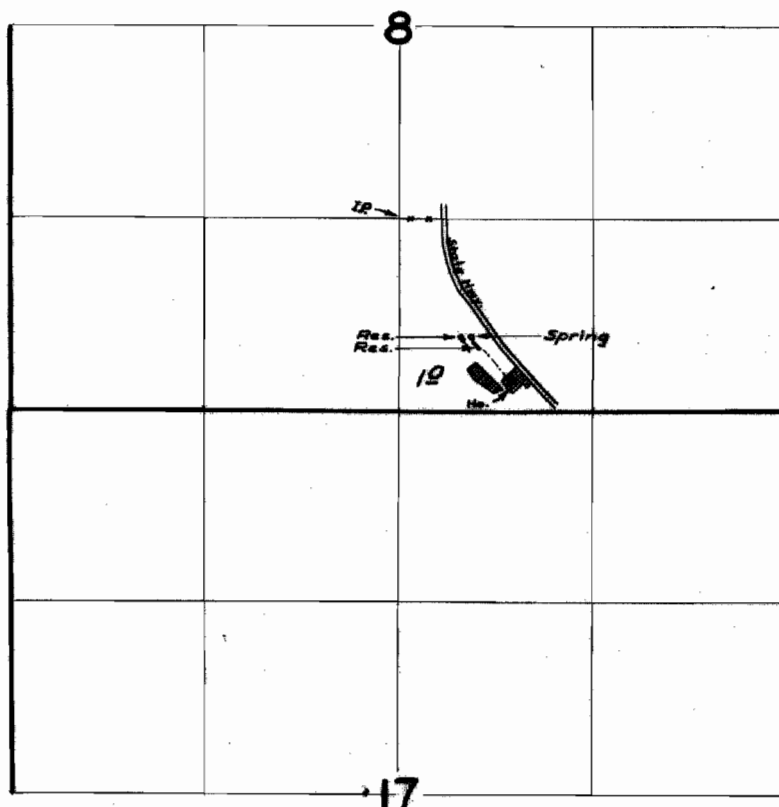

**FINAL PROOF SURVEY
UNDER**

R-28832 *R-1529*
Application No. 26599 Permit No. 22416
IN NAME OF

MARVIN F. & MARION A. FEIGUM

Surveyed 21 Aug 1958, by M. Bish