


T.7S. R.3W.W.M.

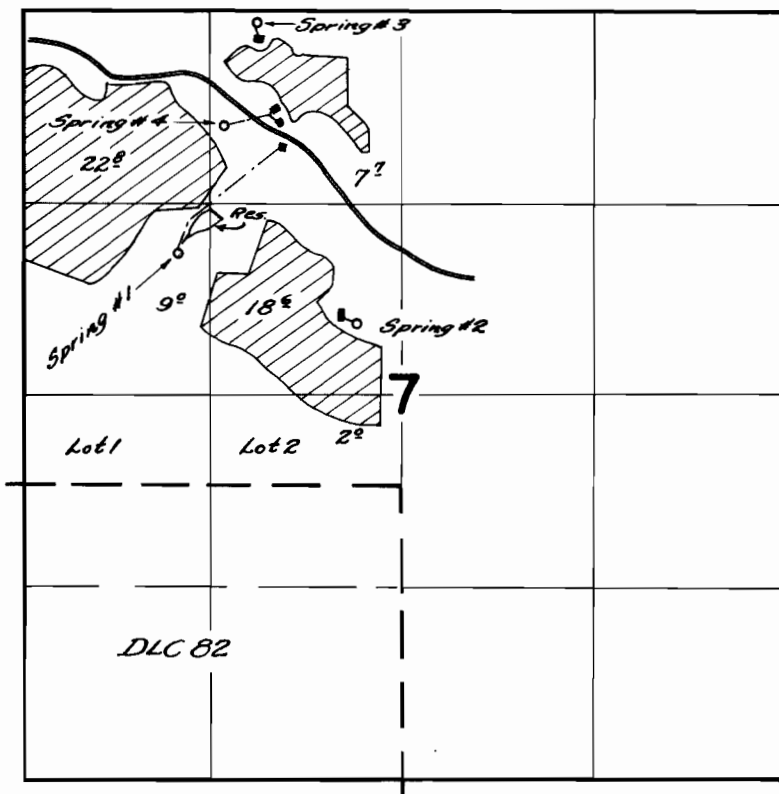

FINAL PROOF SURVEY
UNDER

Application No. *R-28532* 27159 Permit No. *R-1526* 22419
IN NAME OF

FRED L. MEYER

Surveyed *March 19* 1959, by *C.O. Bartels*