


T. 7 S. R. 1 E. W. M.

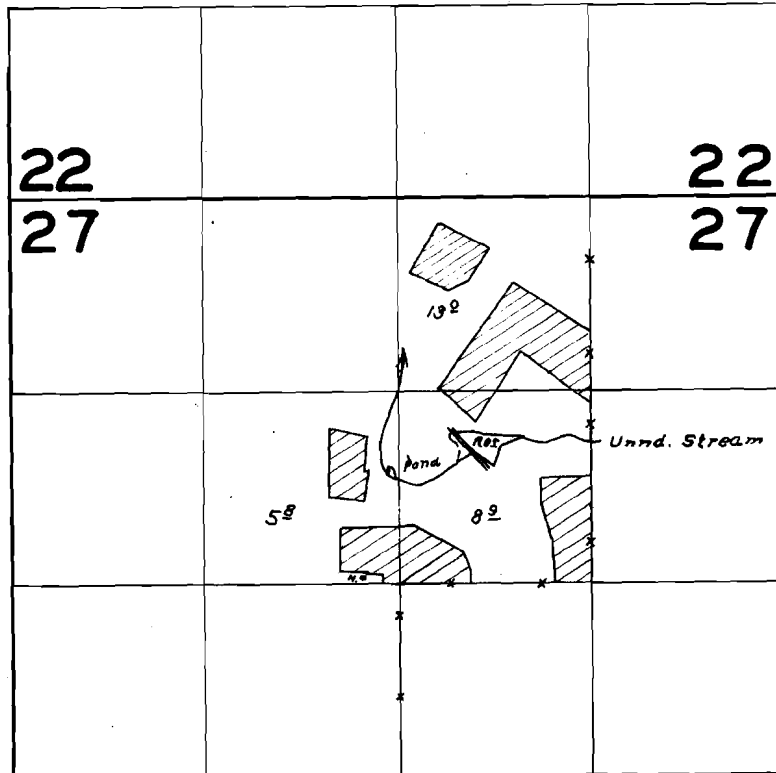

FINAL PROOF SURVEY UNDER

Application No. ²⁸¹³² *R-28158* Permit No. ²²⁴⁷⁶ *R-1536*
IN NAME OF

Clarence Koehler

Surveyed *March 20 19 59*, by *R. H. Jackson*