


27055

27055

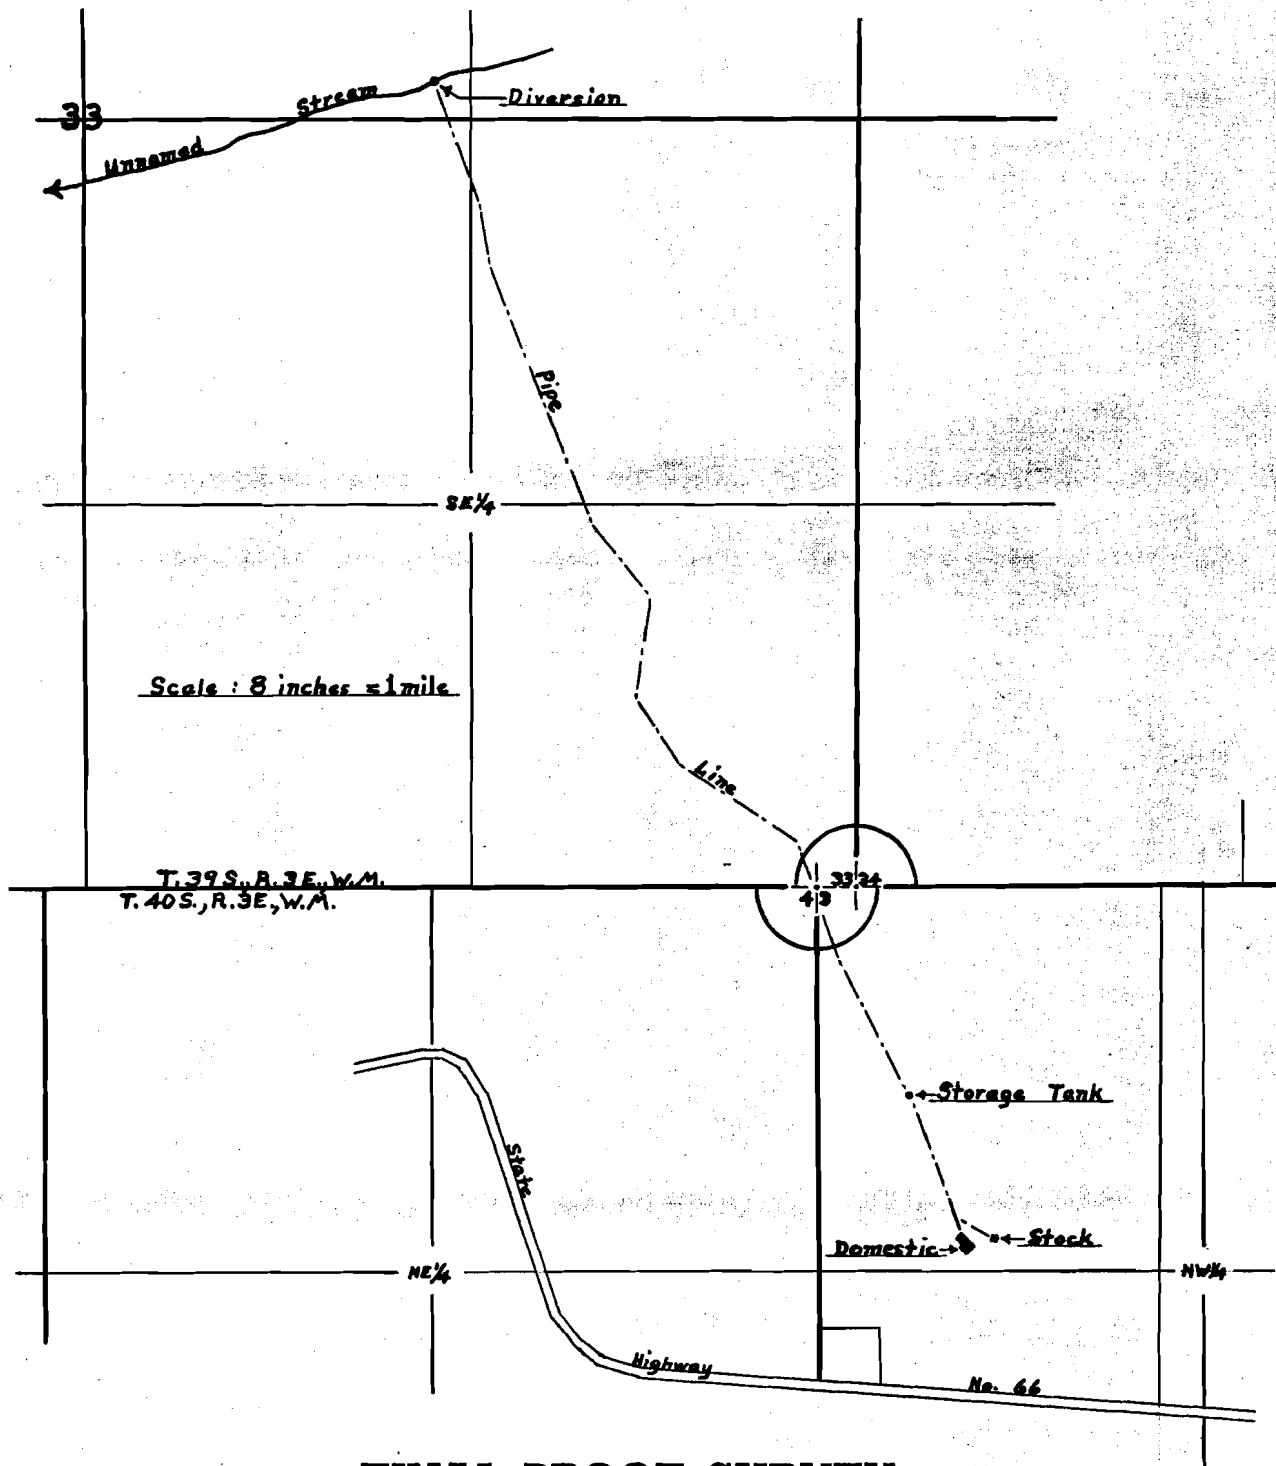

FINAL PROOF SURVEY

UNDER

Application No. 28601..... Permit No. 22532.....

IN NAME OF

Mrs. Ruth Peterson.

Surveyed Dec. 12... 1956., by D.C. Hendrix, WM.

RECEIVED
DEC 17 1956
STATE ENGINEER
GALIN, OREGON