
T. 23S.R. 7 W.W.M.

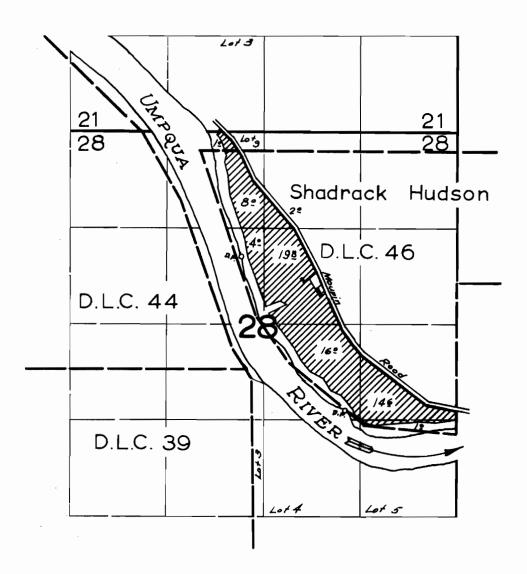

FINAL PROOF SURVEY

Application No. 26285 Permit No. 20631 IN NAME OF
EUGENE H. FISHER
Surveyed June 16-17 1959, by Attackson