


# T. 40S. R. 19E.W.M.

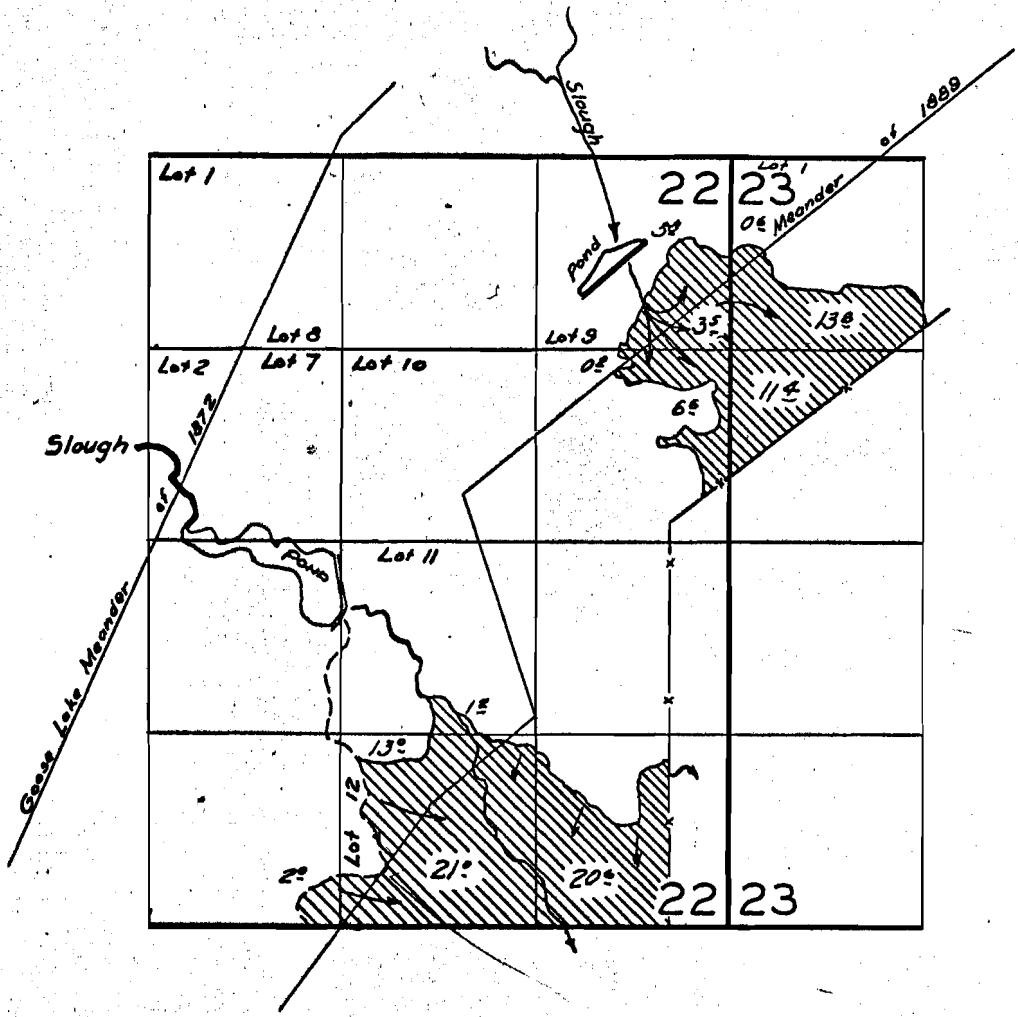

## FINAL PROOF SURVEY UNDER

Primary

Application No. 27352. Permit No. 22806.  
IN NAME OF

RAYMOND E. FISHER

Surveyed May...13. 1959, by R.H. Jackson

40-19  
CHZ-56K-169