


# T. 3N. R. 10W. W.M.

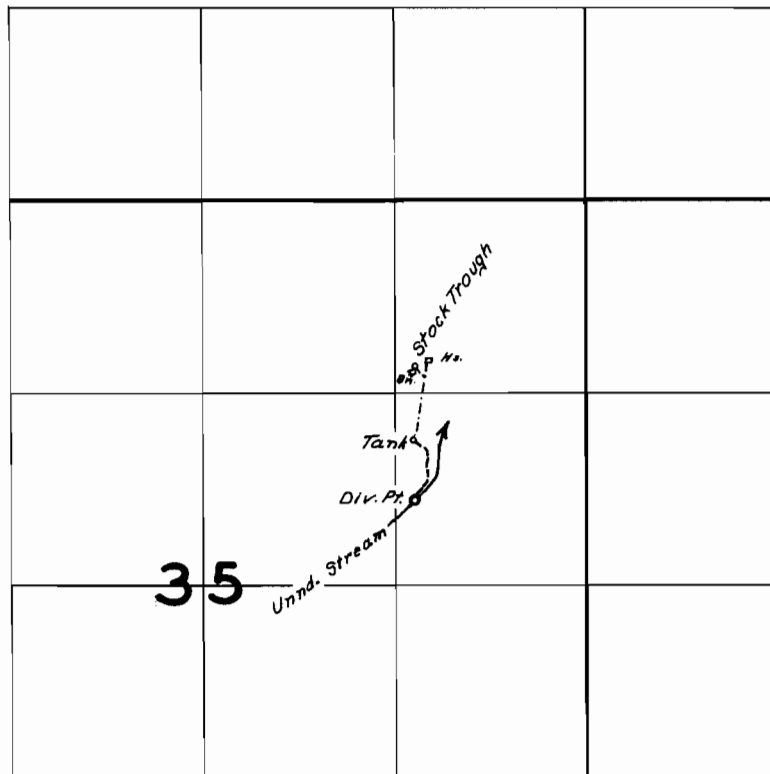

## FINAL PROOF SURVEY UNDER

Application No. *29079* Permit No. *22867*  
IN NAME OF

*A.F. & Bernice Tubbesing*

Surveyed *April 13, 1959*, by *R.H. Jackson*