


T. 15. R. 43E. W.M.

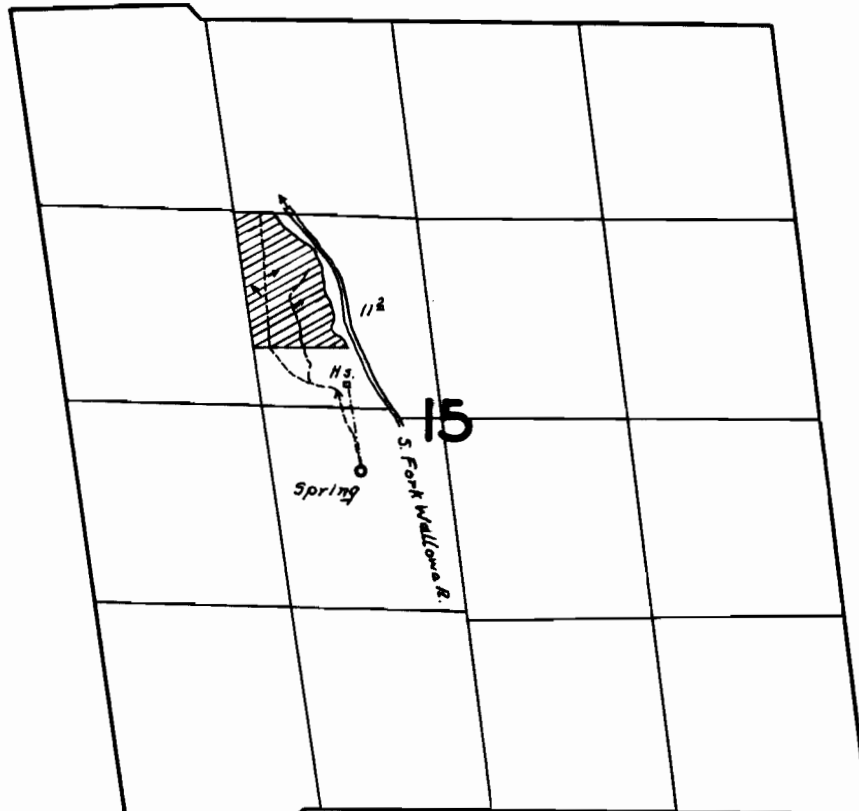

FINAL PROOF SURVEY UNDER

Application No. *27202* Permit No. *22887*
IN NAME OF

M. R. Moffit

Surveyed *Aug. 10, 1959*, by *R. H. Jackson*