


# T. 5S. R. 1W. W.M.

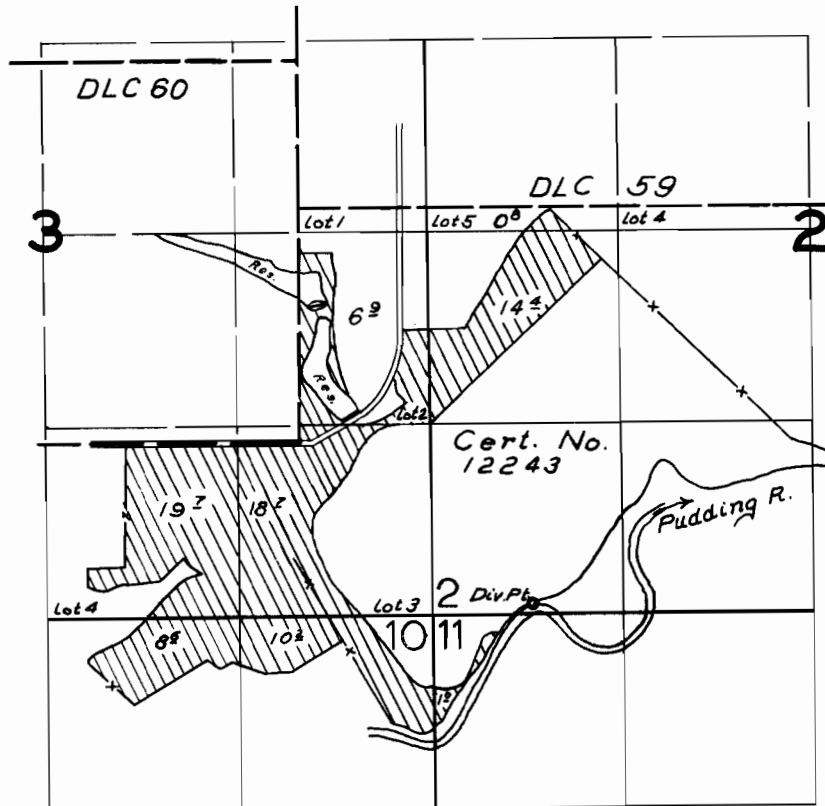

## FINAL PROOF SURVEY UNDER

Application No. 29075 Permit No. 22913  
IN NAME OF

*Manton A. Carl*

Surveyed May 22, 1959, by *R.H. Jackson*