


T.11&12S. R.5W.W.M.

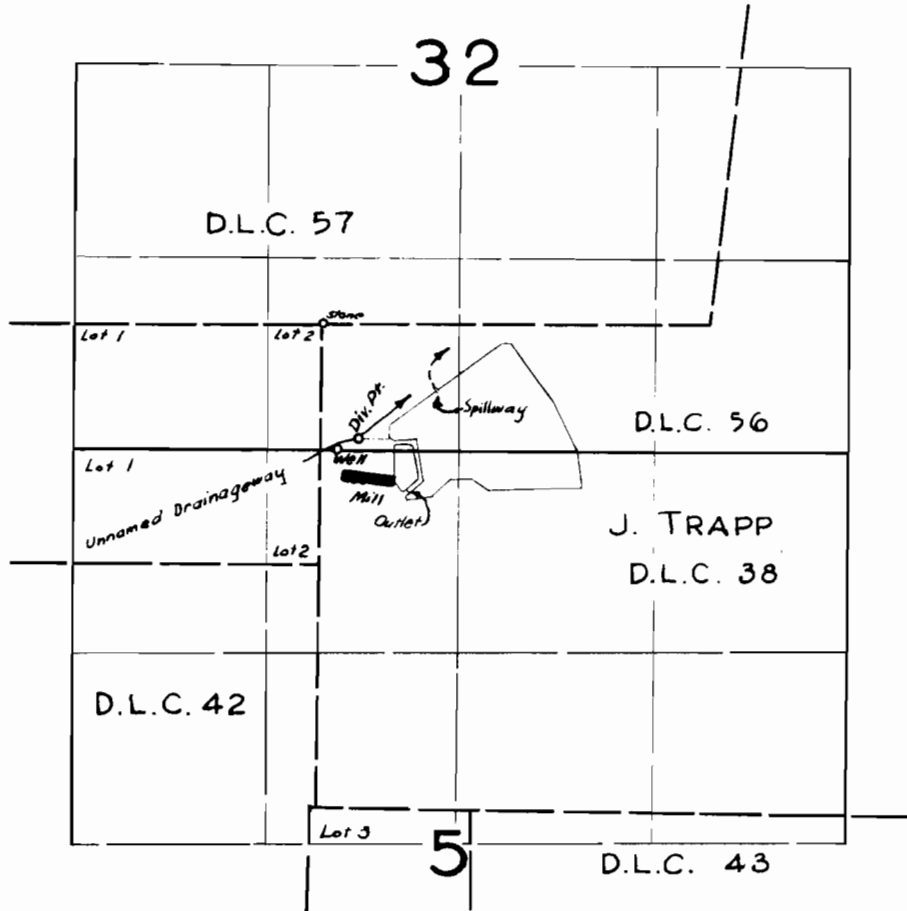

**FINAL PROOF SURVEY**  
UNDER

Application No. <sup>G-282</sup> ~~28446~~ <sub>28494</sub>      Permit No. <sup>G-271</sup> ~~R-1627~~ <sub>22967</sub>  
IN NAME OF

Surveyed 12 March 1959 , by R.H. Jackson