


T.37S. R.5W.W.M.

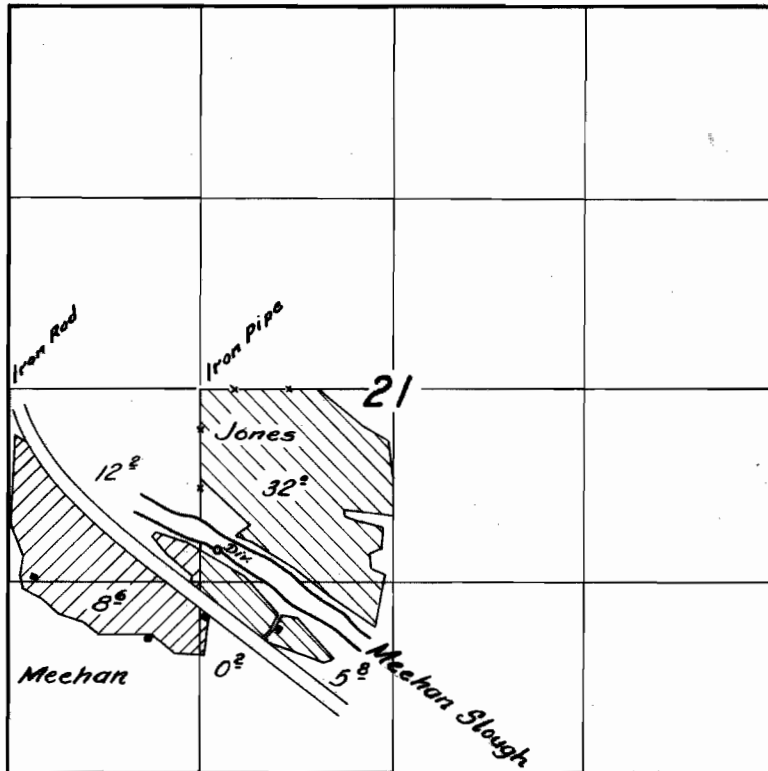

FINAL PROOF SURVEY

UNDER

Application No. 29316 Permit No. 23036

IN NAME OF

J. B. Meehan

Surveyed July 21, 1959, by C. O. Baites