


T. 4 S. R. 5 W. W.M.

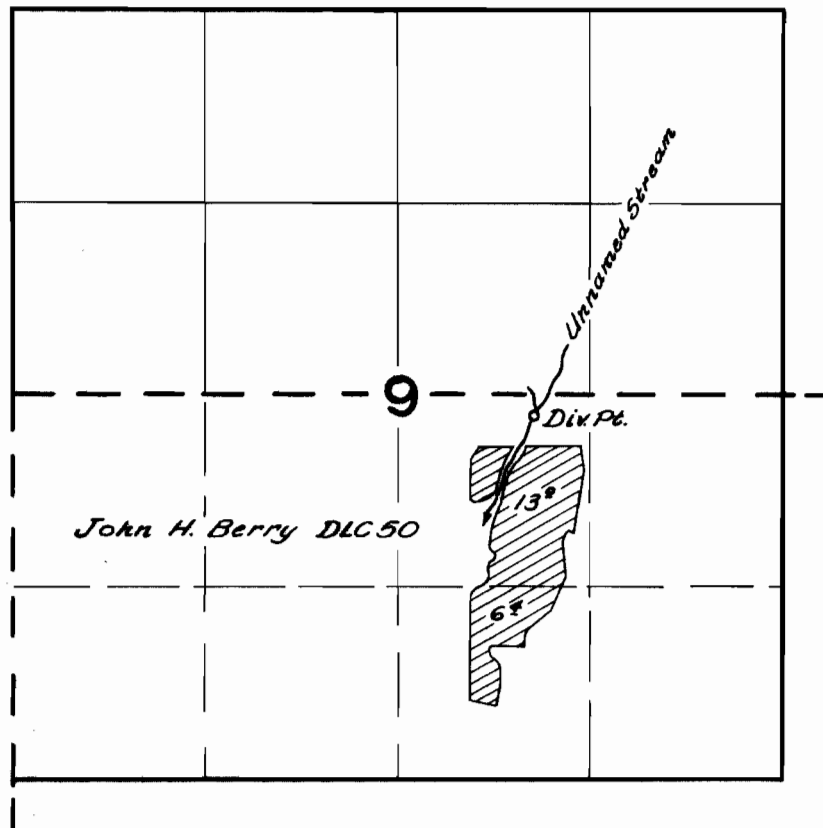

FINAL PROOF SURVEY
UNDER

Application No. *29420* Permit No. *23166*
IN NAME OF

Ralph Nickus

Surveyed *May 9* 1958, by *M. Bisk*