


T. 1N. R. 40E. W.M.

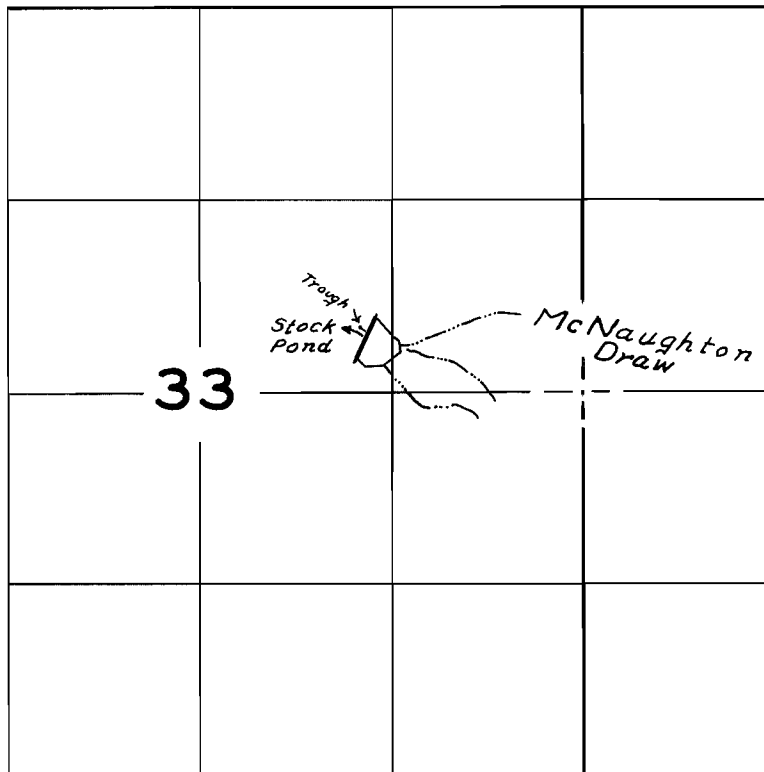

FINAL PROOF SURVEY
UNDER

Application No. *R-28228* *28229* Permit No. *R-1680* *23226*
IN NAME OF

Billy Hindman

Surveyed *Aug. 17* 1959, by *R.H. Jackson*